

**MISSISSIPPI DEPARTMENT OF NATURAL RESOURCES**  
**Bureau of Land and Water Resources**  
 Southport Mall  
 P.O. Box 10631  
 Jackson, Mississippi 39209  
**WATER WELL DRILLERS LOG**

Marshall  
A 2055

12-12 1985 Larry Carpenter Well Co Marshall  
 date well completed firm name county well located

LANDOWNER: Bobby Dodds  
Byhalia, Ms  
RFD  
 (mailing address)

description of formations encountered	from	to
Surface Soil	0	18
Fred. Red Soil	18	40
Fred. white soil	40	65
White Clay	65	90
White Coarse Sand	90-125	

WELL LOCATION:  
 sec. 23 T 1 N R 5 E  
S W  
1 miles North of Barata  
 (distance) (direction) (nearest town)

WELL PURPOSE: None  
 (home, irrigation, municipal, industrial)

**WELL COMPLETION DATA:**

- (1) diameter (inches) 4
- (2) total depth (feet) 125
- (3) static water level (feet) 68 below above top of ground.
- (4) casing PVC, 115'  
 (material) (depth)  
 (size) If telescope see back.
- (5) screen 10', 115'  
 (length) (depth to top)  
4", PVC  
 (size) (material)
- (6) pump 1/2, 10  
 (HP) (yield gpm)  
Elco  
 (type power)
- (7) electric log No  
 (yes or no)  
 (organization running log)
- (8) how well bottom plugged Pvc Cap


**RECEIVED**  
**JUL 29 1986**

Department of Natural Resources  
 Bureau of Land & Water

DRILLERS REMARKS:

If well telescopes please sketch and show depths.

GROUND LEVEL

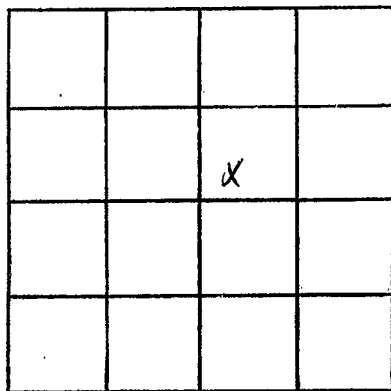

SECTION 23

Please indicate well location X.

ADDITIONAL INFORMATION

If more than one screen, show locations of each on sketch.