

MISSISSIPPI DEPARTMENT OF NATURAL RESOURCES
Bureau of Land and Water Resources
 Southport Mall
 P.O. Box 10631
 Jackson, Mississippi 39209
WATER WELL DRILLERS LOG

Marshall
 A 2056

1 - 12 1986 *Larry Carpenter Well Co.* *Marshall*
 date well completed firm name county well located

LANDOWNER: *Mike Garcia*
Byhalia, ms
RFD
 (mailing address)

description of formations encountered	from	to
<i>Surface Soil</i>	<i>0</i>	<i>18</i>
<i>Fred. White Sand</i>	<i>18</i>	<i>60</i>
<i>Fred Fine Sand</i>	<i>60</i>	<i>90</i>
<i>White Fred Sand</i>	<i>90</i>	<i>120</i>
<i>White Coarse Sand</i>	<i>120</i>	<i>160</i>


WELL LOCATION:
 sec. *22* T-*1* N R-*4* E
 S W
2 1/2 miles *north* of *Cayce*
 (distance) (direction) (nearest town)

WELL PURPOSE: *Home*
 (home, irrigation, municipal, industrial)

WELL COMPLETION DATA:

- (1) diameter (inches) *4*
- (2) total depth (feet) *160*
- (3) static water level (feet) *95* below above top of ground.
- (4) casing *PVC*, *150'*
 (material) (depth)
 (size) if telescope see back.
- (5) screen *10'*, *150'*
 (length) (depth to top)
4", *PVC*
 (size) (material)
- (6) pump *1/2* *10*
 (HP) (yield gpm)
Elec
 (type power)
- (7) electric log *no*
 (yes or no)
 (organization running log)
- (8) how well bottom plugged *PVC Cap*

DRILLERS REMARKS:

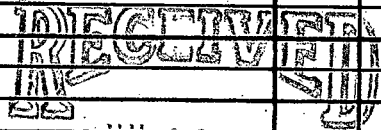


JUL 23 1985

Department of Natural Resources
 Bureau of Land & Water Resources

If well telescopes please
sketch and show depths.

GROUND LEVEL

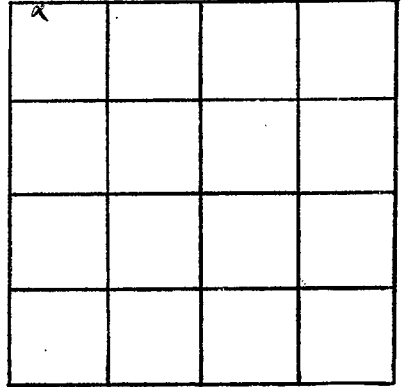

SECTION 22

Please indicate well location X.

ADDITIONAL INFORMATION

If more than one screen,
show locations of each on sketch.