

MISSISSIPPI DEPARTMENT OF NATURAL RESOURCES
 Bureau of Land and Water Resources
 Southport Mall
 P.O. Box 10631
 Jackson, Mississippi 39209
WATER WELL DRILLERS LOG

Marshall
A 2057

1-30 1986 Harry Carpenter Well Co. Marshall
 date well completed firm name county well located

LANDOWNER: Jim McColough
Bydala, Ms.
RFD
 (mailing address)

description of formations encountered	from	to
<u>Surface Soil</u>	<u>0</u>	<u>20</u>
<u>Med. Red Sand</u>	<u>20</u>	<u>34</u>
<u>Med White Sand</u>	<u>34</u>	<u>68</u>
<u>White Coarse Sand</u>	<u>68</u>	<u>70</u>
<u>White Clay</u>	<u>70</u>	<u>84</u>
<u>White Coarse Sand</u>	<u>84</u>	<u>120</u>

WELL LOCATION:
 sec. 23 T. 1 N. R. 5 E.
1 miles north of Barton
 (distance) (direction) (nearest town)

WELL PURPOSE: Home
 (home, irrigation, municipal, industrial)

WELL COMPLETION DATA:

- (1) diameter (inches) 4
- (2) total depth (feet) 120
- (3) static water level (feet) 85 below top of ground.
- (4) casing PVC, 110' (material) (depth)
 (size) If telescope see back.
- (5) screen 10', 110' (length) (depth to top)
4", PVC (size) (material)
- (6) pump 3/4, 12 (HP) (yield gpm)
Elec. (type power)
- (7) electric log no (yes or no)
 (organization running log)
- (8) how well bottom plugged PVC cap


DRILLERS REMARKS:

RECEIVED
 JUL 23 1986

Department of Natural Resources
 Bureau of Land & Water Resources

If well telescopes please
sketch and show depths.

GROUND LEVEL

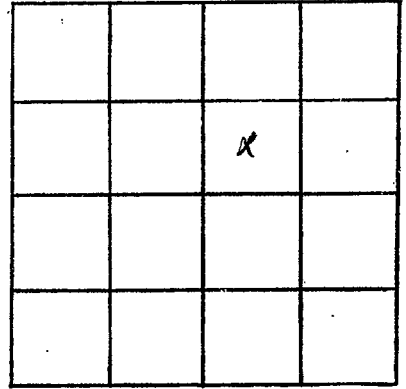

SECTION _____

Please indicate well location X.

ADDITIONAL INFORMATION

If more than one screen,
show locations of each on sketch.