

MISSISSIPPI DEPARTMENT OF NATURAL RESOURCES

Bureau of Land and Water Resources

Southport Mall

P.O. Box 10631

Jackson, Mississippi 39209

WATER WELL DRILLERS LOG

Marshall
A 2058

Feb. 19 1986 Harry Carpenter Wellb. Marshall
date well completed firm name county well located


LANDOWNER:	description of formations encountered	from	to
<u>Magnolia Trail Park</u>			
<u>Hwy 72</u>	<u>Surface Soil</u>	<u>0</u>	<u>19</u>
<u>Byhalia, ms.</u> (mailing address)	<u>Red Clay</u>	<u>19</u>	<u>34</u>
WELL LOCATION: sec. <u>22</u> T <u>1</u> N R. <u>4</u> E S W	<u>White Clay</u>	<u>34</u>	<u>45</u>
<u>2 1/2</u> miles <u>north</u> of <u>Coyne</u> (distance) (direction) (nearest town)	<u>Med. White Sand</u>	<u>45</u>	<u>65</u>
WELL PURPOSE: <u>Trailer Park</u> (home, irrigation, municipal, industrial)	<u>White Clay</u>	<u>65</u>	<u>87</u>
WELL COMPLETION DATA:	<u>Fine White Sand</u>	<u>87</u>	<u>105</u>
(1) diameter (inches) <u>4</u>	<u>White coarse sand</u>	<u>105</u>	<u>165</u>
(2) total depth (feet) <u>165</u>			
(3) static water level (feet) <u>110</u> below above top of ground.			
(4) casing <u>PVC</u> , <u>140'</u> (material) (depth)			
(size) If telescope see back.			
(5) screen <u>25'</u> , <u>14'</u> (length) (depth to top)			
<u>4"</u> , <u>PVC</u> (size) (material)			
(6) pump _____ (HP) _____ (yield gpm)			
<u>Elec.</u> (type power)			
(7) electric log <u>no</u> (yes or no)			
(organization running log)			
(8) how well bottom plugged <u>PVC cap</u>			
DRILLERS REMARKS:			

REGISTERED
WATER WELL
JUL 23 1986

Department of Natural Resources
Bureau of Land & Water Resources

If well telescopes please sketch and show depths.

GROUND LEVEL

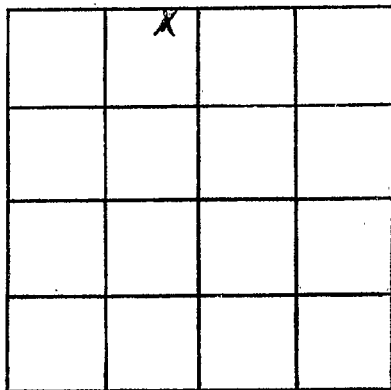

SECTION 22

Please indicate well location X.

ADDITIONAL INFORMATION

If more than one screen, show locations of each on sketch.