

MISSISSIPPI DEPARTMENT OF NATURAL RESOURCES
 Bureau of Land and Water Resources
 Southport Mall
 P.O. Box 10631
 Jackson, Mississippi 39209
WATER WELL DRILLERS LOG

MARSHALL
A 2060

5-19 1986 Larry Carpenter Well Marshall
 date well completed firm name county well located

LANDOWNER: Charles Patten
Byhalia, ms
RFD
 (mailing address)

description of formations encountered	from	to
<u>Surface Soil</u>	<u>0</u>	<u>20</u>
<u>Med. Red Sand</u>	<u>20</u>	<u>36</u>
<u>Med. White Sand</u>	<u>36</u>	<u>60</u>
<u>Coarse White Sand</u>	<u>60</u>	<u>82</u>
<u>White clay</u>	<u>82</u>	<u>94</u>
<u>White Coarse Sand</u>	<u>94</u>	<u>125</u>

WELL LOCATION:
 sec. 23 T 1 N R 5 E
 S W
1 miles north of Barton
 (distance) (direction) (nearest town)

WELL PURPOSE: Home
 (home, irrigation, municipal, industrial)

- WELL COMPLETION DATA:
- (1) diameter (inches) 4
 - (2) total depth (feet) 125
 - (3) static water level (feet) 20 below above top of ground.
 - (4) casing PVC, 125',
 (material) (depth)
 (size) if telescope see back.
 - (5) screen 6', 115'
 (length) (depth to top)
4", PVC
 (size) (material)
 - (6) pump 1/2 10
 (HP) (yield gpm)
Elec
 (type power)
 - (7) electric log no
 (yes or no)
 (organization running log)
 - (8) how well bottom plugged PVC Cap


DRILLERS REMARKS:

RECEIVED
 JUL 25 1986

Department of Natural Resources
 Bureau of Land & Water Resources

If well telescopes please sketch and show depths.

GROUND LEVEL

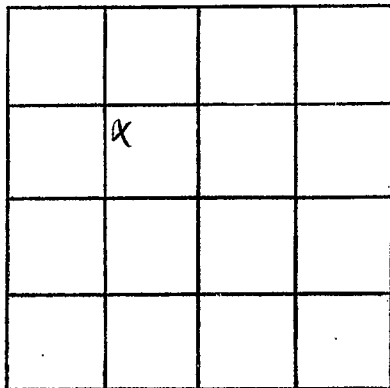

SECTION 23

Please indicate well location X.

ADDITIONAL INFORMATION

If more than one screen,
show locations of each on sketch.