

**MARSHALL**  
**B**  
**12-20-72**

MISSISSIPPI  
 BOARD OF WATER COMMISSIONERS  
 416 North State Street  
 Jackson, Mississippi 39201

**CODED**

**WATER WELL DRILLERS LOG**

**12-20** 19**72** **Atkinson & Frost** **Marshall**  
 date well completed firm name county well located

**LANDOWNER:**  
**New Hope Baptist Church**  
 (mailing address)

description of formations encountered	from	to
Red Clay	0	15
Red Sand	15	100
White sand	100	155
Clay sand mix	155	220
White Sand	220	240

**WELL LOCATION:**  
 sec. **2** T. **1** N. R. **5** E  
**3** miles **NE** of **Snyder**  
 (distance) (direction) (nearest town)

**WELL PURPOSE:**  
 (home, irrigation, municipal, industrial)

**WELL COMPLETION DATA:**

(1) diameter (inches) **4 1/2**

(2) total depth (feet) **240**

(3) static water level (feet) **130** below top of ground.

(4) casing **PVC** **230**  
 (material) (depth)

\_\_\_\_\_ If telescope see back.  
 (size)

(5) screen **230** **240**  
 (length) (depth to top)

\_\_\_\_\_ (size) \_\_\_\_\_ (material)

(6) pump **3/4** **7**  
 (HP) (yield gpm)

**1/2**  
 (type power)

(7) electric log **no**  
 (yes or no)

\_\_\_\_\_ (organization running log)


(8) how well bottom plugged **Cap.**

**DRILLERS REMARKS:**

11 1973

If well telescopes please sketch and show depths.

GROUND LEVEL

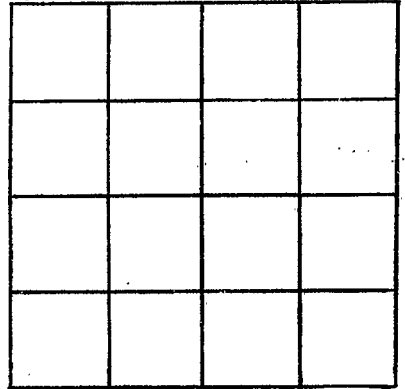

SECTION \_\_\_\_\_

Please indicate well location X.

ADDITIONAL INFORMATION

If more than one screen, show locations of each on sketch.