

B
MARSHALL
8-10-73

MISSISSIPPI
BOARD OF WATER COMMISSIONERS
416 North State Street
Jackson, Mississippi 39201

CODED

WATER WELL DRILLERS LOG

Aug. 10 1973 R.L. Carpenter Marshall
date well completed firm name county well located

LANDOWNER E.O. Anderson
Mt. Pleasant, Miss
(mailing address)

description of formations encountered	from	to
Surface Soil	0	8
med. white sand	8	28
med Brown sand	28	48
white clay	48	60
white fine sand	60	91
white coarse sand	91	127

WELL LOCATION:
sec. 33 T-1 N R-3 E
1/2 miles of Mt. Pleasant
(distance) (direction) (nearest town)

WELL PURPOSE: Home
(home, irrigation, municipal, industrial)

WELL COMPLETION DATA:


- (1) diameter (inches) 4
- (2) total depth (feet) 127
- (3) static water level (feet) 78 below top of ground.
- (4) casing Plastic, 114 ft. (material) (depth)
(size) If telescope see back.
- (5) screen 13 ft., 114 ft. (length) (depth to top)
1/2 in., Plastic & Steel (size) (material)
- (6) pump 1 (HP) 20 (yield gpm)
2 hp (type power)
- (7) electric log No (yes or no)
- (organization running log)
- (8) how well bottom plugged Plastic cap

DRILLERS REMARKS:

AUG 17 1973

If well telescopes please sketch and show depths.

GROUND LEVEL

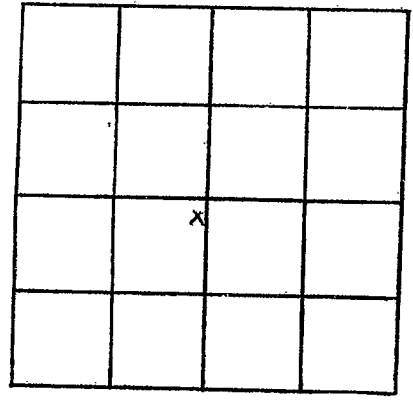

SECTION 33

Please indicate well location X.

ADDITIONAL INFORMATION

Lined area for additional information.

If more than one screen, show locations of each on sketch.