

15E

Marshall
B2
9-3-68

MISSISSIPPI
BOARD OF WATER COMMISSIONERS
416 North State Street
Jackson, Mississippi 39201

CODED

CODED

WATER WELL DRILLERS LOG

Sept. 3 1968 R. L. Carpenter Marshall
date well completed firm name county well located

LANDOWNER: Bremer Whaley
Mt. Pleasant, Miss.

description of formations encountered	from	to
Surface Soil	0	10
med white sand	10	55
Fine white sand & white clay	55	82
Med white sand	82	110
White coarse sand	110	133

(mailing address)

WELL LOCATION:
sec. 33 T-1 N R-3 E
in Mt. Pleasant
(distance) miles (direction) of (nearest town)

WELL PURPOSE:
(home, irrigation, municipal, industrial)

WELL COMPLETION DATA:
(1) diameter (inches) 4 in.
(2) total depth (feet) 133
(3) static water level (feet) 110 below top of ground.
(4) casing Plastic, 127 Ft. (material) (depth)
(size) if telescope see back.
(5) screen 6 ft., 127 Ft. (length) (depth to top)
4 in., Plastic & Iron (size) (material)
(6) pump 3/4 HP, 12 (yield gpm)
Elec. (type power)
(7) electric log no (yes or no)
(organization running log)

CODED

(8) how well bottom plugged Plastic Plug

DRILLERS REMARKS:

JAN 29 1969


MISS. BD. OF
WATER COMM.

If well telescopes please sketch and show depths.

GROUND LEVEL

R3W

T15

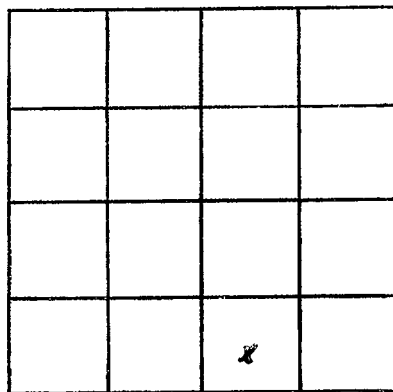

SECTION 33

Please indicate well location X.

ADDITIONAL INFORMATION

If more than one screen, show locations of each on sketch.