

16N

MARSHALL

BA

10-31-68

MISSISSIPPI BOARD OF WATER COMMISSIONERS
416 North State Street
Jackson, Mississippi 39201

CODED

CODED

WATER WELL DRILLERS LOG

10-31-68
date well completed

W. Atkinson & Son
firm name

Marshall
county well located

LANDOWNER:

Daniel Gullage


description of formations encountered

from to

RT 1 James
(mailing address)

Red Clay	0	10
Red sand	10	50
White sand	50	95
White clay	95	120
White sand	120	158

WELL LOCATION:

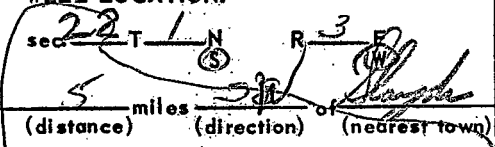

(distance) (direction) (nearest town)

WELL PURPOSE:

(home, irrigation, municipal, industrial)

WELL COMPLETION DATA:

- (1) diameter (inches) 4 1/2
- (2) total depth (feet) 158
- (3) static water level (feet) 120 below above top of ground.
- (4) casing (material) _____ (depth) _____
(size) _____ If telescope see back.
- (5) screen 10 ft (length) _____ (depth to top) _____
(size) _____ (material) _____
- (6) pump 1/2 (HP) 12 (yield gpm)
Elec (type power)
- (7) electric log no (yes or no)
(organization running log) _____
- (8) how well bottom plugged _____

CODED

NOV 27 1968


MISS. Bd. OF WATER COMMISSIONERS

DRILLERS REMARKS:

See log

If well telescopes please sketch and show depths.

GROUND LEVEL

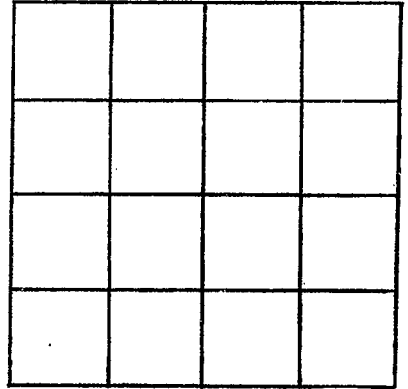

SECTION _____

Please indicate well location X.

ADDITIONAL INFORMATION

If more than one screen, show locations of each on sketch.