

Marshall
B 5
4-69

MISSISSIPPI
BOARD OF WATER COMMISSIONERS
416 North State Street
Jackson, Mississippi 39201

CODED

WATER WELL DRILLERS LOG

April 12 1969 Bumpus Well Co Marshall
date well completed firm name county well located

LANDOWNER:
Ray Harris
Mt. Pleasant, Miss.
(mailing address)

description of formations encountered	from	to
<u>Clay</u>	<u>0</u>	<u>3</u>
<u>Sand</u>	<u>3</u>	<u>130</u>

WELL LOCATION:
sec. 22 T 15 N R 3 E
1/4 miles West of Mt. Pleasant
(distance) (direction) (nearest town)

WELL PURPOSE:
(home, irrigation, municipal, industrial)

WELL COMPLETION DATA:

- (1) diameter (inches) 4"
- (2) total depth (feet) 130
- (3) static water level (feet) 80 below above top of ground.
- (4) casing 4" 123
(material) (depth)
- 4" If telescope see back.
(size)
- (5) screen 79' 123
(length) (depth to top)
- 4" gravel wall
(size) (material)
- (6) pump 3/4 10
(HP) (yield gpm)
- Elect
(type power)
- (7) electric log yes or no
- (organization running log)
- (8) how well bottom plugged 4" plug


DRILLERS REMARKS:

ALL 4
MISS. Bd. OF WATER COMM.

06
1-5
200-100

If well telescopes please sketch and show depths.

GROUND LEVEL

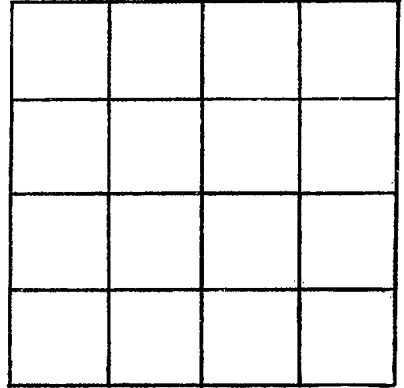

SECTION _____

Please indicate well location X.

ADDITIONAL INFORMATION

If more than one screen, show locations of each on sketch.