

Marshall
B 8
3-6-70

MISSISSIPPI
BOARD OF WATER COMMISSIONERS
416 North State Street
Jackson, Mississippi 39201

WATER WELL DRILLERS LOG

COPIED

2-6 1970 Robert W. Wilson Marshall
date well completed firm name county well located

LANDOWNER: Emerette Hamm
Mt Pleasant
Miss
(mailing address)

WELL LOCATION:
sec 23 T 1 N R 3 E
S W
miles of
(distance) (direction) (nearest town)

WELL PURPOSE: Home
(home, irrigation, municipal, industrial)

- WELL COMPLETION DATA:
- (1) diameter (inches) 4"
 - (2) total depth (feet) 168
 - (3) static water level (feet) 120 below top of ground.
 - (4) casing Plaster 164 (material) (depth)
4 (size) if telescope see back.
 - (5) screen 4 (length) 164 (depth to top)
4 (size) Gravel Pack (material)
 - (6) pump 3/4 (HP) 15 (yield gpm)
Electric (type power)
 - (7) electric log (yes or no)
(organization running log)
 - (8) how well bottom plugged 4
Plastic cap

description of formations encountered	from	to
Red Clay Red sand	0	20
Red sand white clay	20	40
Red sand	40	100
Red sand Rock	100	120
White sand white clay	120	140
White clay white sand	140	150
White sand	150	168

COPIED


MAR 13 1970

MISS. BD. OF
WATER COMM

DRILLERS REMARKS:

If well telescopes please sketch and show depths.

GROUND LEVEL

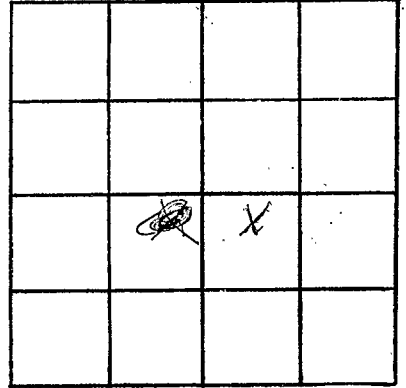

SECTION 33

Please indicate well location X.

ADDITIONAL INFORMATION

If more than one screen,
show locations of each on sketch.