

Marshall
 B9
 8-27-70

MISSISSIPPI
 BOARD OF WATER COMMISSIONERS
 416 North State Street
 Jackson, Mississippi 39201

CODED

WATER WELL DRILLERS LOG

8-27 1970 Robert W. Wilson Marshall
 date well completed firm name county well located

LANDOWNER: E.L. Bailey
 Mt. Pleasant
 Miss.
 (mailing address)

description of formations encountered	from	to
Red Clay Red Sand	0	20
Red Sand Brown Clay	20	40
Red Sand White Clay	60	80
White Clay White Sand	80	100
White Sand White Clay	100	120
White Sand White Clay	120	140
White Sand	140	163

WELL LOCATION:
 sec. 33 T-1 N R-3 E
 (distance) miles of (direction) (nearest town)

WELL PURPOSE:
 (home, irrigation, municipal, industrial)

- WELL COMPLETION DATA:
- (1) diameter (inches) 4
 - (2) total depth (feet) 163
 - (3) static water level (feet) 100 below top of ground.
 - (4) casing Plastic, 159 (material) (depth)
 2" If telescope see back. (size)
 - (5) screen 4 159 (length) (depth to top)
 4 Bored Tech (size) (material)
 - (6) pump 3/4 20 (HP) (yield gpm)
 Electric (type power)
 - (7) electric log (yes or no)

(organization running log)

(8) how well bottom plugged 4' Plastic Cap

DRILLERS REMARKS:


CODED

SEP 24 1970

MISS. Bd. of WATER COMMISSIONERS

If well telescopes please sketch and show depths.

GROUND LEVEL

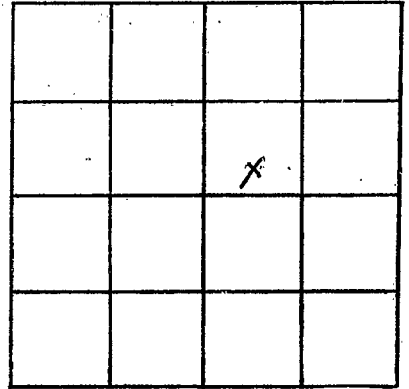

SECTION _____

Please indicate well location X.

ADDITIONAL INFORMATION

If more than one screen,
show locations of each on sketch.