

Marshall
B 10
6-4-70

MISSISSIPPI
 BOARD OF WATER COMMISSIONERS
 416 North State Street
 Jackson, Mississippi 39201

CODED

WATER WELL DRILLERS LOG

June 4 19 70 R. L. Carpenter Marshall
 date well completed firm name county well located

LANDOWNER: Kathern Owen
Mt. Pleasant, Miss.
 (mailing address)

WELL LOCATION:
 sec. 33 T 1 N R 3 E
in Mt. Pleasant
 (distance) miles (direction) of (nearest town)

WELL PURPOSE: drinking
 (home, irrigation, municipal, industrial)

- WELL COMPLETION DATA:
- (1) diameter (inches) 4 in.
 - (2) total depth (feet) 140
 - (3) static water level (feet) 90 below above top of ground.
 - (4) casing Plastic, 134 ft.
 (material) (depth)
 (size) if telescope see back.
 - (5) screen 6 ft., 134 ft.
 (length) (depth to top)
4 in., Plastic & Strand
 (size) (material)
 - (6) pump 1/2 8
 (HP) (yield gpm)
Electric
 (type power)
 - (7) electric log no
 (yes or no)
 - (organization running log)
 - (8) how well bottom plugged Plastic cap

description of formations encountered	from	to
<u>Surface Soil</u>	<u>0</u>	<u>13</u>
<u>Med. Fine White Sand</u>	<u>13</u>	<u>46</u>
<u>Med. Red Sand</u>	<u>46</u>	<u>83</u>
<u>White Clay</u>	<u>83</u>	<u>96</u>
<u>White Fine Sand</u>	<u>96</u>	<u>120</u>
<u>White Coarse Sand</u>	<u>120</u>	<u>140</u>

CODED

JUL 13 1970


DRILLERS REMARKS:

MISS. BD. OF
 WATER COMM.

If well telescopes please sketch and show depths.

GROUND LEVEL

R3 W

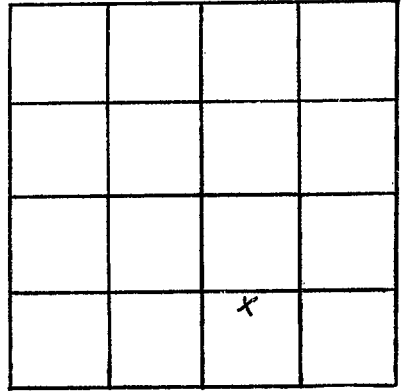

SECTION 33

Please indicate well location X.

ADDITIONAL INFORMATION

If more than one screen, show locations of each on sketch.