

MARSHALL

B 11

7-15-70

MISSISSIPPI  
BOARD OF WATER COMMISSIONERS  
416 North State Street  
Jackson, Mississippi 39201

**CODED**

WATER WELL DRILLERS LOG

July 15 1970 R L Carpenter Marshall  
date well completed firm name county well located

LANDOWNER: Wilbur Mackey  
Mt. Pleasant  
Miss.  
(mailing address)

description of formations encountered

from to

Surface Soil	0	8
Coarse white sand	8	37
med white sand	37	80
White Clay	80	92
Med white sand	92	105
Coarse white sand	105	127

WELL LOCATION:

sec. 33 T 1 N R 3 E  
in Mt. Pleasant  
(distance) (direction) (nearest town)

WELL PURPOSE: Home  
(home, irrigation, municipal, industrial)

WELL COMPLETION DATA:

- (1) diameter (inches) 4 in
- (2) total depth (feet) 127
- (3) static water level (feet) 83 below top of ground.
- (4) casing Plastic, 121 ft.  
(material) (depth)  
(size) if telescope see back.
- (5) screen 6 ft., 121 ft.  
(length) (depth to top)  
4 in., Plastic & Sand  
(size) (material)
- (6) pump 3/4 10  
(HP) (yield gpm)  
Elec  
(type power)
- (7) electric log No  
(yes or no)

**CODED**

(organization running log)  
Plastic Plug

(8) how well bottom plugged

DRILLERS REMARKS:


DEC 7 1970

MISS. BD. OF WATER CL.

If well telescopes please sketch and show depths.

GROUND LEVEL

R3W

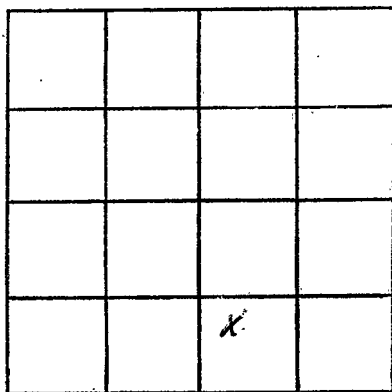

SECTION 33

Please indicate well location X.

ADDITIONAL INFORMATION

If more than one screen, show locations of each on sketch.