

MARSHALL

B 13

9-12-70

MISSISSIPPI BOARD OF WATER COMMISSIONERS 416 North State Street Jackson, Mississippi 39201

CODED

WATER WELL DRILLERS LOG

Sept. 12 1970 date well completed

R. L. Carpenter firm name

Marshall county well located

LANDOWNER: Sara Thomas

Red Banks, Miss

R.F.D. (mailing address)

WELL LOCATION:

sec. 3 T-1 N R-3 E in Mt. Pleasant miles of (nearest town)

WELL PURPOSE: Home (home, irrigation, municipal, industrial)

WELL COMPLETION DATA:

- (1) diameter (inches) 4 in
(2) total depth (feet) 148
(3) static water level (feet) 95 below top of ground
(4) casing Plastic, 142 ft (material) (depth)
(5) screen 6 ft, 142 ft (length) (depth to top)
4 in, Plastic & Sand (size) (material)
(6) pump 3/4 HP, 10 (yield gpm)
Elec. (type power)
(7) electric log no (yes or no)

(organization running log) Plastic Plug
(8) how well bottom plugged

description of formations encountered

from to

Table with 3 columns: description of formations encountered, from, to. Rows include Surface Soil (0-18), Coarse white sand (18-45), Med white sand (45-93), White clay (93-100), Fine white sand (100-126), Coarse white sand (126-168).

CODED


DEC 7 1970

DRILLERS REMARKS:

MISS. BD. OF WATER COMM.

If well telescopes please sketch and show depths.

GROUND LEVEL

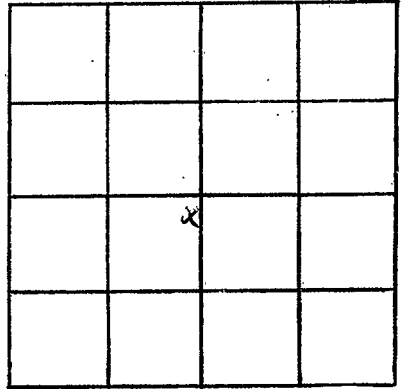

SECTION 33

Please indicate well location X.

ADDITIONAL INFORMATION

If more than one screen, show locations of each on sketch.