

**MARSHALL**  
**B 15**  
**12-1-70**

MISSISSIPPI  
 BOARD OF WATER COMMISSIONERS  
 416 North State Street  
 Jackson, Mississippi 39201

**CODED**

**WATER WELL DRILLERS LOG**

12-1-70 19 T Horpe Well Supply Co. Marshall  
 date well completed firm name county well located

LANDOWNER: Matt Motew  
Mt. Pleasant Miss.  
 (mailing address)

WELL LOCATION:  
 sec. 32 T. 10 N. R. 3 W.  
2 1/2 miles East of Mt. Pleasant  
 (distance) (direction) (nearest town)

WELL PURPOSE:  
 (home, irrigation, municipal, industrial)

WELL COMPLETION DATA:  
 (1) diameter (inches) 4"  
 (2) total depth (feet) 190  
 (3) static water level (feet) 80 below above top of ground.  
 (4) casing PVC NSF 160'  
 (material) (depth)  
 (size) If telescope see back.  
 (5) screen 5' 160'  
 (length) (depth to top)  
20 Slotted  
 (size) (material)  
 (6) pump 1/2 10  
 (HP) (yield gpm)  
33051  
 (type power)  
 (7) electric log No  
 (yes or no)  
 (organization running log)

description of formations encountered	from	to
Top Soil	0	5
Red Shale + Clay mixed	5	34
white clay	34	56
coarse Gray sand	56	71
white clay	71	73
coarse white sand	73	75
med white sand	75	159
med coarse white sand	159	170
coarse white sand	170	190

**CODED**

JAN 25 1971


MISS. DE. OF  
 WATER COMM.

(8) how well bottom plugged END of casing plugged with cap

DRILLERS REMARKS:

If well telescopes please sketch and show depths.

GROUND LEVEL

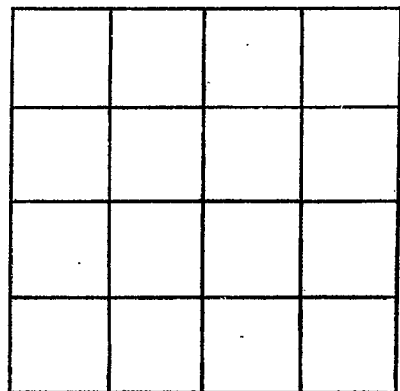

SECTION \_\_\_\_\_

Please indicate well location X.

ADDITIONAL INFORMATION

If more than one screen, show locations of each on sketch.