

MARSHALL
B 16
12-11-70

MISSISSIPPI
BOARD OF WATER COMMISSIONERS
416 North State Street
Jackson, Mississippi 39201

CODED

WATER WELL DRILLERS LOG

12-11 1970 date well completed
J T Meallin firm name
Marshall county well located

LANDOWNER: Church of Christ
Mt Pleasant
~~1111111111~~
(mailing address)

description of formations encountered	from	to
Clay	0	9
Sandy	9	70
Clay	70	78
Sand	78	120

WELL LOCATION:
sec 29 T 1 N R 3 E
3 miles (distance) S.W. of Mt Pleasant (nearest town)

WELL PURPOSE:
(home, irrigation, municipal, industrial)

- WELL COMPLETION DATA:
- (1) diameter (inches) 4
 - (2) total depth (feet) 120
 - (3) static water level (feet) 70 below top of ground.
 - (4) casing P 120 (material) (depth)
(size) if telescope see back.
 - (5) screen 20 100 (length) (depth to top)
(size) (material)
 - (6) pump 4.5 (HP) (yield gpm)
E (type power)
 - (7) electric log (yes or no)
(organization running log)
 - (8) how well bottom plugged Rock.

CODED


FEB 2 1971

MISS. Bd. OF
WATER COMMISSIONERS

DRILLERS REMARKS:

If well telescopes please sketch and show depths.

GROUND LEVEL

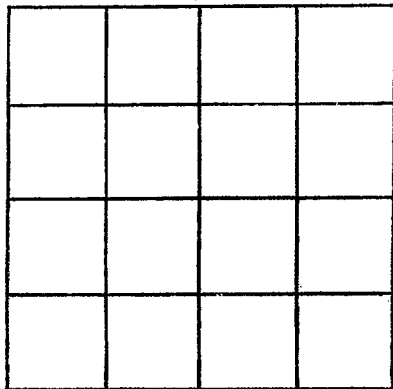

SECTION _____

Please indicate well location X.

ADDITIONAL INFORMATION

If more than one screen, show locations of each on sketch.