

**MARSHALL**  
**B17**  
**3-10-71**

MISSISSIPPI  
 BOARD OF WATER COMMISSIONERS  
 416 North State Street  
 Jackson, Mississippi 39201

**CODED**

WATER WELL DRILLERS LOG

*March 10* 19 *71* *R. L. Conquest* *Marshall*  
 date well completed firm name county well located

LANDOWNER: *Mrs. Willie Mc Douglas*  
*Mt. Pleasant,*  
*Miss.*  
 (mailing address)

WELL LOCATION:  
 sec *33* T *1* N R *3* E  
*in Mt. Pleasant*  
 (distance) miles (direction) of (nearest town)

WELL PURPOSE: *Home*  
 (home, irrigation, municipal, industrial)

WELL COMPLETION DATA:

- (1) diameter (inches) *4*
- (2) total depth (feet) *137*
- (3) static water level (feet) *102* below above top of ground.
- (4) casing *Plastic*, *137 ft.*  
 (material) (depth)
- (size) if telescope see back.
- (5) screen *6 ft.*, *131 ft.*  
 (length) (depth to top)
- 1/2 in. Plastic & Hand*  
 (size) (material)
- (6) pump *3/4* *10*  
 (HP) (yield gpm)
- Elec.*  
 (type power)
- (7) electric log *No*  
 (yes or no)

(organization running log)

(8) how well bottom plugged *Plastic Plug*

description of formations encountered	from	to
<i>Surface soil</i>	<i>0</i>	<i>8</i>
<i>med. white sand</i>	<i>8</i>	<i>28</i>
<i>Coarse white sand</i>	<i>28</i>	<i>60</i>
<i>white clay</i>	<i>60</i>	<i>69</i>
<i>Med &amp; Fine white sand</i>	<i>69</i>	<i>110</i>
<i>Coarse white sand</i>	<i>110</i>	<i>137</i>

**CODED**


MAY 3 - 1971

MISS. RD. 05  
 WATER COMMISSIONERS

DRILLERS REMARKS:

If well telescopes please sketch and show depths.

GROUND LEVEL

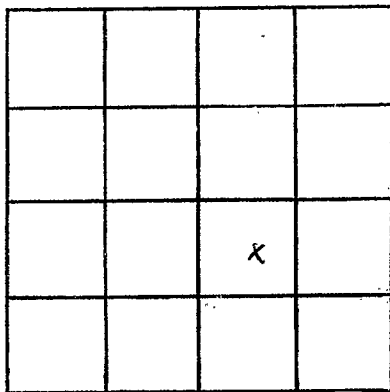

SECTION 33

Please indicate well location X.

ADDITIONAL INFORMATION

If more than one screen, show locations of each on sketch.