

MARSHALL
B-19
5-22-71

MISSISSIPPI
 BOARD OF WATER COMMISSIONERS
 416 North State Street
 Jackson, Mississippi 39201

WATER WELL DRILLERS LOG

CODED
Marshall

May 22 19 *71* *R. L. Carpenter*
 date well completed firm name

county well located

LANDOWNER: *Eddie Dixon*
Mt. Pleasant, Miss

description of formations encountered	from	to
<i>Surface Soil</i>	<i>0</i>	<i>10</i>
<i>med. Red Sand</i>	<i>10</i>	<i>31</i>
<i>med white sand</i>	<i>31</i>	<i>65</i>
<i>+ white clay</i>	<i>65</i>	<i>78</i>
<i>white coarse sand</i>	<i>78</i>	<i>117</i>

(mailing address)

WELL LOCATION:

sec. *30* T *1* N R. *3* E
 S W
1 1/2 miles *East* of *mt. Pleasant*
 (distance) (direction) (nearest town)

WELL PURPOSE: *Home*
 (home, irrigation, municipal, industrial)

WELL COMPLETION DATA:

- (1) diameter (inches) *4*
- (2) total depth (feet) *117*
- (3) static water level (feet) *82* below above top of ground.
- (4) casing *Plastic*, *117ft*
 (material) (depth)
 (size) if telescope see back.
- (5) screen *6ft*, *117ft*
 (length) (depth to top)
4in. Plastic Gravel
 (size) (material)
- (6) pump *3/4* *10*
 (HP) (yield gpm)
Elec.
 (type power)
- (7) electric log *No*
 (yes or no)

(organization running log)

(8) how well bottom plugged *Plastic Plug*


SEP 2 1971

DRILLERS REMARKS:

MISS. RD. 67
 WATER BOARD

If well telescopes please sketch and show depths.

GROUND LEVEL

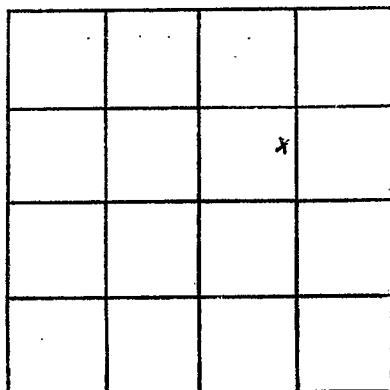

SECTION 34

Please indicate well location X.

ADDITIONAL INFORMATION

If more than one screen,
show locations of each on sketch.