

Marshall
B-21
5-25-71

MISSISSIPPI
BOARD OF WATER COMMISSIONERS
416 North State Street
Jackson, Mississippi 39201

CODED

WATER WELL DRILLERS LOG

May 25 1971 R.L. Carpenter Marshall
date well completed firm name county well located

LANDOWNER: Olba R. Jones

Moore, Tenn.

R.F.D.

(mailing address)

description of formations
encountered

from

to

Surface Soil

0

12

Med Red Sand

12

30

Med. White Sand

30

75

White Clay

75

87

White Fine Sand

87

120

White Coarse Sand

120

155

WELL LOCATION:

sec 36 T 1 S R 3 W
1 1/2 miles west of Dayton
(distance) (direction) (nearest town)

WELL PURPOSE: None
(home, irrigation, municipal, industrial)

WELL COMPLETION DATA:

- (1) diameter (inches) 4
(2) total depth (feet) 155
(3) static water level (feet) 125 below
top of ground.
(4) casing Plastic, 149 ft
(material) (depth)

(size) If telescope see back.

- (5) screen 6 ft, 1 1/2 ft
(length) (depth to top)

4 in. Plastic & Metal
(size) (material)

- (6) pump 3/4, 10
(HP) (yield gpm)

Elec.
(type power)

- (7) electric log No
(yes or no)

(organization running log)

- (8) how well bottom plugged Plastic Plug


DRILLERS REMARKS:

SEP 7 1971

MISS. BD. OF
WATER COMM.

If well telescopes please
sketch and show depths.

GROUND LEVEL

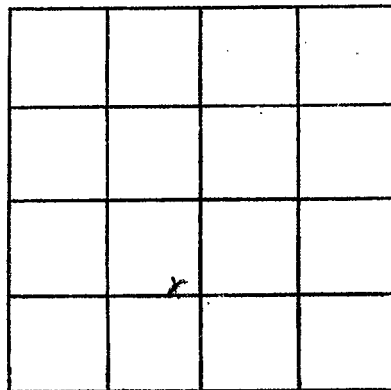

SECTION 36

Please indicate well location X.

ADDITIONAL INFORMATION

If more than one screen,
show locations of each on sketch.