

Marshall

MISSISSIPPI BOARD OF WATER COMMISSIONERS

B23

B-66

WATER WELL DRILLERS LOG

CODED

Date: Aug. 16, 1966, Driller: Larry Carpenter County Marshall (Name)

(1) Owner of Land: Elwood Pierce (Name) Mt. Pleasant, Miss. (Address)

(2) Location: 1/4, 1/4, Sec. 33 T15R34 (Address) miles west (direction) of Mt. Pleasant (Nearest Town)

(3) Topography: Hilly (Hilly) (Flat) (Level)

(4) Purpose of Well: Residential (Domestic Irrigation Municipal, Industrial, Other)

Information upon completion of well:

(1) Diameter 4 inches.

(2) Total Depth 120 feet.

(3) Water Level 90 feet below top of ground.

(4) Cased to 113, Size 4"

(5) Screen: Size 4, Length 7 ft.


(6) Were any formations sealed against pollution? yes, X no.

If YES depth of formation

Why

Drillers Remarks:

Description & Color of Materials Sand, Clay, Red Clay, Shell, etc.	Thick- ness Feet	Depth Feet
Surface Soil to	10	10
Medium white sand from 10		
ft. to 34 ft.	24	34
Sand rock from 34 to 35 ft.	1	35
Red Clay from 35 to 47 ft.	12	47
Medium Red sand from 47 ft. to 70 ft.	23	70
White Clay from 70 ft. to 84 ft.	14	84
White coarse sand from 84 to 120 ft.	46	120

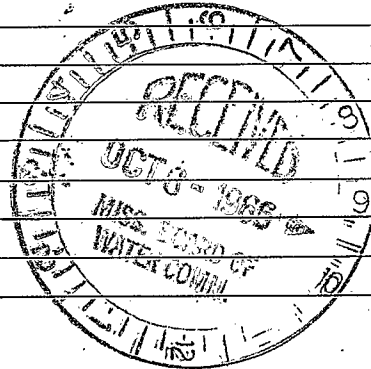

(Use Back Side)

Well No.

1870
1871
1872
1900