

Marshall  
B24  
9-66

MISSISSIPPI BOARD OF WATER COMMISSIONERS

WATER WELL DRILLERS LOG **CODED**

Date: Sept. 27 19 66, Driller: Larry Carpenter County Marshall  
(When well drilled) (Name) (Where well is located)

(1) Owner of Land: Janie R. Huddle  
(Name)  
Mt. Pleasant, Miss.  
(Address)

(2) Location: N 1/4, NE 1/4, Sec. 33, T15R3W  
\_\_\_\_\_ miles at, of Mt Pleasant  
(distance) (direction) (Nearest Town)

(3) Topography: Hilly  
(Hilly) (Flat) (Level)

(4) Purpose of Well: Resident  
(Domestic Irrigation, Municipal, Industrial, Other)

Description & Color of Materials Sand, Clay, Red Clay, Shell, etc.	Thick- ness Feet	Depth Feet
<u>Surface soil</u>	<u>12</u>	<u>12</u>
<u>medium white sand</u>	<u>27</u>	<u>39</u>
<u>hard rock</u>	<u>1</u>	<u>40</u>
<u>medium Red sand</u>	<u>31</u>	<u>71</u>
<u>white clay</u>	<u>6</u>	<u>78</u>
<u>white coarse sand</u>	<u>42</u>	<u>120</u>


Information upon completion of well:

- (1) Diameter 4 inches.
- (2) Total Depth 120 feet.
- (3) Water Level 85 feet below top of ground.
- (4) Cased to 113, Size 4 in.
- (5) Screen: Size 4 in., Length 7 ft.
- (6) Were any formations sealed against pollution?  
\_\_\_\_\_ yes, X no.

If YES depth of formation \_\_\_\_\_  
Why \_\_\_\_\_

Drillers Remarks: \_\_\_\_\_  
Yield in gpm: 13  
Size pump: 3/4 H.P. - Submersible Pump  
Type power: Elec. 220 volts

**CODED**

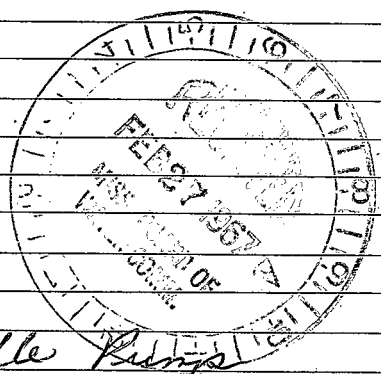

[The page contains extremely faint and illegible text, likely bleed-through from the reverse side of the document. The text is too light to transcribe accurately.]