

Marshall  
B28  
8-67

MISSISSIPPI  
BOARD OF WATER COMMISSIONERS  
416 North State Street  
Jackson, Mississippi 39201

**CODED**

WATER WELL DRILLERS LOG

Aug. 12 19 67 R. L. Carpenter Marshall  
date well completed firm name county well located

LANDOWNER: Willie Jordan  
Mt. Pleasant,  
Miss. RFD  
(mailing address)

WELL LOCATION:  
sec. 35 T. 1 N. R. 3 E  
1 1/2 miles East of Mt. Pleasant  
(distance) (direction) (nearest town)


WELL PURPOSE: None  
(home, irrigation, municipal, industrial)

WELL COMPLETION DATA:

- (1) diameter (inches) 4
- (2) total depth (feet) 135
- (3) static water level (feet) 100 below top of ground.
- (4) casing Plastic, 129, (material) (depth)
- \_\_\_\_\_ if telescope see back. (size)
- (5) screen 6 ft., 129 (length) (depth to top)
- 4 in. Plastic & Gravel (size) (material)
- (6) pump 3/4 (HP) 12 (yield gpm)
- Elec. (type power)
- (7) electric log no (yes or no)
- \_\_\_\_\_ (organization running log)
- (8) how well bottom plugged Plastic Plug

description of formations encountered	from	to
Surface Soil	0	10
Red Clay	10	17
Med. white sand	17	32
Red & white coarse sand mixed	32	95
White Clay	95	114
White coarse sand	114	135

**CODED**

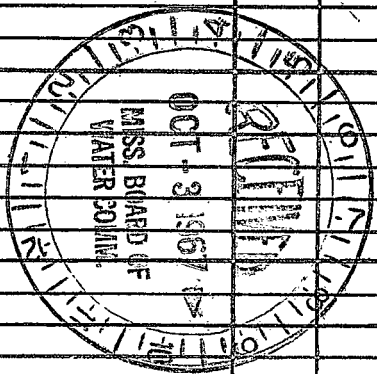

DRILLERS REMARKS:

If well telescopes please sketch and show depths.

GROUND LEVEL

R3w

X/15

		X	

SECTION 35

Please indicate well location X.

ADDITIONAL INFORMATION

If more than one screen,  
show locations of each on sketch.