

Aug 72 + 34

MARSHALL  
B29  
10-67

MISSISSIPPI  
BOARD OF WATER COMMISSIONERS  
416 North State Street  
Jackson, Mississippi 39201

**CODED**

WATER WELL DRILLERS LOG

Oct. 4, 1967 19 R. L. Carpenter Marshall  
date well completed firm name county well located

LANDOWNER: Holder Rhea

description of formations encountered from to

Moscow, Tenn.

Surface soil 0 12

(mailing address)

Medium Red sand 12 19

WELL LOCATION:

sec. 25 T-1 N R-3 E  
2 miles NW of Slayden  
(distance) (direction) (nearest town)

White clay 19 21

Coarse Red & white sand mixed 21 33

WELL PURPOSE: Home  
(home, irrigation, municipal, industrial)

White coarse sand 33 90

WELL COMPLETION DATA:

white clay 90 93

(1) diameter (inches) 4

white coarse sand 93 127

(2) total depth (feet) 127

(3) static water level (feet) 90 below above top of ground.

(4) casing Plastic, 121,  
(material) (depth)

         if telescope see back.  
(size)

(5) screen 6 ft., 121  
(length) (depth to top)

4 in., Plastic & gravel  
(size) (material)

(6) pump 3/4 12 GPM  
(HP) (yield gpm)


Eber  
(type power)

(7) electric log no  
(yes or no)

          
(organization running log)

(8) how well bottom plugged Plastic Clay

DRILLERS REMARKS:

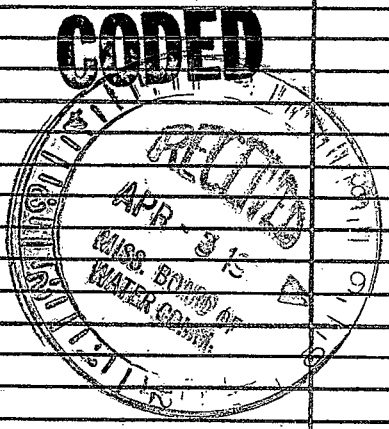

If well telescopes please sketch and show depths.

GROUND LEVEL

R 3W

T15

			X

SECTION 25

Please indicate well location X.

ADDITIONAL INFORMATION

If more than one screen, show locations of each on sketch.