

MARSHALL

B 30

12-6-71

MISSISSIPPI BOARD OF WATER COMMISSIONERS  
416 North State Street  
Jackson, Mississippi 39201

DEC 17 1971

WATER WELL DRILLERS LOG

**CODED**

12-6 date well completed

1971 Dean & K. Port Lumber, Inc. firm name

Marshall county well located

LANDOWNER:

Ronald Lee McRae

Mt. Pleasant, Miss.  
(mailing address)

description of formations encountered

clay

sand

from

to

0

20

20

145

WELL LOCATION:

sec. 33 T 1 N R 3 E  
(S) (W)

In the middle of Mt. Pleasant  
(distance) (direction) (nearest town)

WELL PURPOSE:

Drinking  
(home, irrigation, municipal, industrial)

WELL COMPLETION DATA:

- (1) diameter (inches) 4"
- (2) total depth (feet) 145 feet
- (3) static water level (feet) 100 below above top of ground.

(4) casing PVC, 145  
(material) (depth)

(size) If telescope see back.

(5) screen 6 ft, 139 ft  
(length) (depth to top)

4" gravel soil  
(size) (material)

(6) pump 3/4, 12  
(HP) (yield gpm)

(type power)

(7) electric log  
(yes or no)

(organization running log)


(8) how well bottom plugged 4" cap

**CODED**

DRILLERS REMARKS:

If well telescopes please sketch and show depths.

GROUND LEVEL

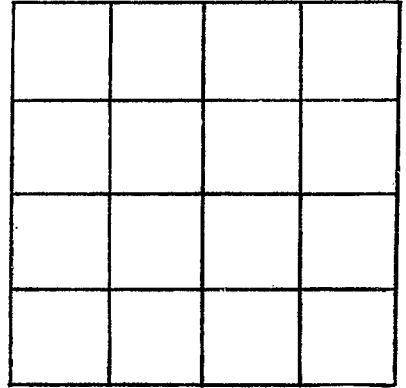

SECTION \_\_\_\_\_

Please indicate well location X.

ADDITIONAL INFORMATION

If more than one screen,  
show locations of each on sketch.