

MARSHALL
B32
5-72

MISSISSIPPI
 BOARD OF WATER COMMISSIONERS
 416 North State Street
 Jackson, Mississippi 39201

CODED

WATER WELL DRILLERS LOG

May 19 72 Robert W. Wilson Marshall
 date well completed firm name county well located

LANDOWNER: JV Monte denio
72 Madison Ave
Memphis, Tenn
 (mailing address)

description of formations encountered	from	to
	Red Clay - Red sand	0
Red sand	20	60
" " white clay	60	80
" " "	80	100
White sand " "	100	120
" " "	120	196

WELL LOCATION:
 sec. 29 T 1 N S R 3 E W
 (distance) miles (direction) of (nearest town)

WELL PURPOSE:
 (home, irrigation, municipal, industrial)

WELL COMPLETION DATA:

- (1) diameter (inches) 4"
- (2) total depth (feet) 196
- (3) static water level (feet) _____ below above top of ground.
- (4) casing plastic (material), 196 (depth),
 _____ if telescope see back.
 (size)
- (5) screen _____ (length) _____ (depth to top)
 (size) _____ (material)
- (6) pump 5hp (HP) 100 (yield gpm)
Elec (type power)
- (7) electric log ✓ (yes or no)
 _____ (organization running log)
- (8) how well bottom plugged 4"
plastic Cup

CODED


JUN 29 1972

DRILLERS REMARKS:

MISS. Bd. of
 WATER COM.

If well telescopes please sketch and show depths.

GROUND LEVEL

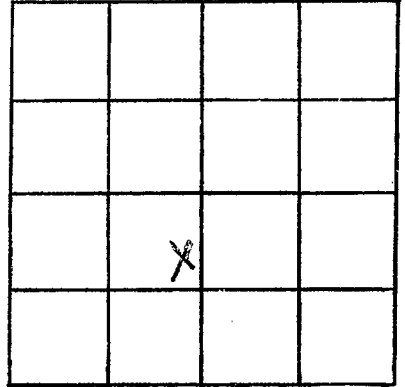

SECTION 29

Please indicate well location X.

ADDITIONAL INFORMATION

If more than one screen, show locations of each on sketch.