

**MARSHALL**  
**B35**  
**4-18-72**

MISSISSIPPI  
 BOARD OF WATER COMMISSIONERS  
 416 North State Street  
 Jackson, Mississippi 39201

WATER WELL DRILLERS LOG **CODED**

April 18 1972 R. L. Carpenter Marshall  
 date well completed firm name county well located

LANDOWNER: <u>H. V. Hunsicker</u>	description of formations encountered	from	to
<u>Mt. Pleasant, Miss.</u>			
(mailing address)	<u>Surface Soil</u>	<u>0</u>	<u>10</u>
WELL LOCATION: sec. <u>33</u> T <u>1</u> N R <u>3</u> E <u>In Mt. Pleasant</u>	<u>Med Brown Sand</u>	<u>10</u>	<u>30</u>
(distance) miles (direction) of (nearest town)	<u>Med Brown &amp; Red Sand</u>	<u>30</u>	<u>69</u>
WELL PURPOSE: <u>Home</u> (home, irrigation, municipal, industrial)	<u>Med White Sand</u>	<u>69</u>	<u>105</u>
WELL COMPLETION DATA:	<u>white clay</u>	<u>105</u>	<u>112</u>
(1) diameter (inches) <u>4</u>	<u>white coarse sand</u>	<u>112</u>	<u>140</u>
(2) total depth (feet) <u>140</u>			
(3) static water level (feet) <u>105</u> below top of ground.			
(4) casing <u>Plastic</u> , <u>134ft.</u> (material) (depth)			
(size) If telescope see back.			
(5) screen <u>6ft.</u> , <u>134ft.</u> (length) (depth to top)			
<u>4 in. Plastic &amp; Shovel</u> (size) (material)			
(6) pump <u>3/4</u> , <u>10</u> (HP) (yield gpm)			
<u>Elec.</u> (type power)			
(7) electric log <u>No</u> (yes or no)			
(organization running log)			
(8) how well bottom plugged <u>Plastic log</u>			
DRILLERS REMARKS:			


**CODED**

AUG - 4 1972

MISS. BD. OF  
 WATER COMMISSIONERS

If well telescopes please sketch and show depths.

GROUND LEVEL

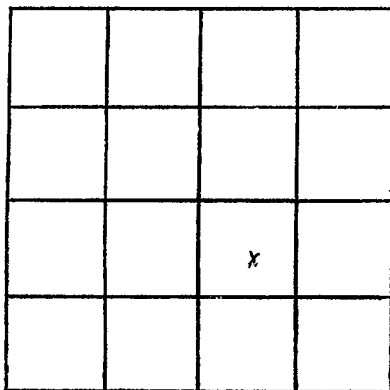

SECTION 33

Please indicate well location X.

ADDITIONAL INFORMATION

A series of horizontal lines for writing additional information, starting below the 'ADDITIONAL INFORMATION' header and extending to the bottom of the page.

If more than one screen, show locations of each on sketch.