

MARSHALL

B 36

5-29-72

MISSISSIPPI BOARD OF WATER COMMISSIONERS 416 North State Street Jackson, Mississippi 39201

WATER WELL DRILLERS LOG

CODED Marshall

May 29 1972 date well completed

R. L. Caposta firm name

Marshall county well located

LANDOWNER: Headstart School

Wt Pleasant, Miss

(mailing address)

WELL LOCATION:

sec 35 T 1 N R 3 E 1/2 miles East of Mt Pleasant (distance) (direction) (nearest town)

WELL PURPOSE: School (home, irrigation, municipal, industrial)

WELL COMPLETION DATA:

- (1) diameter (inches) 4
(2) total depth (feet) 133 ft
(3) static water level (feet) 100 below top of ground.
(4) casing Plastic, 127 ft (material) (depth)
(5) screen 6 ft, 127 ft (length) (depth to top)
(6) pump 3/4 HP, 10 (yield gpm)
(7) electric log no.

(organization running log) Plastic Plug

DRILLERS REMARKS:

Table with 4 columns: description of formations encountered, from, to. Rows include: Surface Soil (0-12), Red clay (12-19), med. & Fine Red Sand (19-35), white Coarse sand (35-89), white Clay (89-110), white Coarse sand (110-133)


CODED

MWG 11/19/72

MISS. BU. WATER BOARD

If well telescopes please sketch and show depths.

GROUND LEVEL

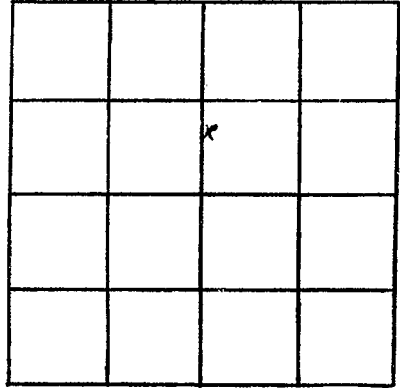

SECTION 35

Please indicate well location X.

ADDITIONAL INFORMATION

If more than one screen, show locations of each on sketch.