

MARSHALL
B37
6-14-72

MISSISSIPPI
 BOARD OF WATER COMMISSIONERS
 416 North State Street
 Jackson, Mississippi 39201

WATER WELL DRILLERS LOG

CODED

June 14 1972 R. L. Carpenter Marshall
 date well completed firm name county well located

LANDOWNER:	description of formations encountered	from	to
<u>Anna King</u> <u>Mt. Pleasant, Miss.</u> (mailing address)	<u>Surface Soil</u>	<u>8</u>	<u>13</u>
WELL LOCATION: sec. <u>33</u> T- <u>1</u> N R- <u>3</u> E <u>Mt. Pleasant</u> (distance) miles (direction) of (nearest town)	<u>Coarse Red Sand</u>	<u>13</u>	<u>35</u>
WELL PURPOSE: (home, irrigation, municipal, industrial)	<u>Med Red Sand</u>	<u>35</u>	<u>53</u>
WELL COMPLETION DATA: (1) diameter (inches) <u>4</u>	<u>White Clay</u>	<u>53</u>	<u>62</u>
(2) total depth (feet) <u>148</u>	<u>Med White Sand</u>	<u>63</u>	<u>120</u>
(3) static water level (feet) <u>105</u> below top of ground.	<u>Fine White Sand</u>	<u>120</u>	<u>128</u>
(4) casing <u>Plaste</u> , <u>142 ft.</u> (material) (depth)	<u>White Coarse Sand</u>	<u>128</u>	<u>148</u>
(size) If telescope see back.			
(5) screen <u>6 ft.</u> , <u>142 ft.</u> (length) (depth to top)			
<u>4 in.</u> , <u>Plastic Band</u> (size) (material)			
(6) pump <u>3/4</u> <u>10</u> (HP) (yield gpm)			
<u>Elec.</u> (type power)			
(7) electric log <u>No.</u> (yes or no)			
(organization running log)			
(8) how well bottom plugged <u>Plastic Log</u>			
DRILLERS REMARKS:			


CODED

AUG - 1 1972

MISS. BD. OF
 WATER COMMISSIONERS

If well telescopes please sketch and show depths.

GROUND LEVEL

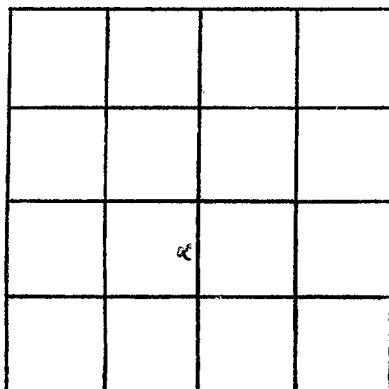

SECTION 33

Please indicate well location X.

ADDITIONAL INFORMATION

A series of horizontal lines for writing additional information, starting below the 'ADDITIONAL INFORMATION' header and extending down to the bottom of the page.

If more than one screen, show locations of each on sketch.