

B 38
MARSHALL
3-19-73

MISSISSIPPI
BOARD OF WATER COMMISSIONERS
416 North State Street
Jackson, Mississippi 39201

CODED

WATER WELL DRILLERS LOG

Mar. 19 1973 R L Carpenter Marshall
date well completed firm name county well located

LANDOWNER: Rather Over
Mt Pleasant,
Miss.
(mailing address)

WELL LOCATION:
sec 33 T 1 N R 3 E
1/4 miles Northwest of Mt Pleasant
(distance) (direction) (nearest town)

WELL PURPOSE: Home
(home, irrigation, municipal, industrial)

- WELL COMPLETION DATA:
- (1) diameter (inches) 4
 - (2) total depth (feet) 127
 - (3) static water level (feet) 84 below above top of ground.
 - (4) casing Plastic, 121 ft.
(material) (depth)
_____ if telescope see back.
(size)
 - (5) screen 6 ft., 121 ft.
(length) (depth to top)
4 in., Plastic & Sand
(size) (material)
 - (6) pump 3/4 10
(HP) (yield gpm)
Elec.
(type power)
 - (7) electric log no
(yes or no)

(organization running log)
 - (8) how well bottom plugged Plastic cap


description of formations encountered	from	to
Surface Soil	6	12
Brown coarse sand	12	23
White med. sand	23	65
White clay	65	68
White Fine sand	68	100
White Coarse sand	100	127

DRILLERS REMARKS:

AUG 17 1973

If well telescopes please sketch and show depths.

GROUND LEVEL

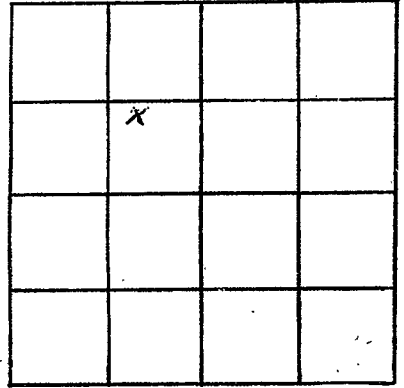

SECTION 33

Please indicate well location X.

ADDITIONAL INFORMATION

If more than one screen,
show locations of each on sketch.