

MARSHALL
B41
10-26-73

MISSISSIPPI
 BOARD OF WATER COMMISSIONERS
 416 North State Street
 Jackson, Mississippi 39201

CODED

WATER WELL DRILLERS LOG

date well completed 10-26-1973 firm name Jennett & Sons Well Drilling county well located Marshall

LANDOWNER:
James Williams Sr.
Star Pt. Resville, Miss.
 (mailing address)

description of formations encountered	from	to
<u>clay</u>	<u>0</u>	<u>20</u>
<u>sand</u>	<u>20</u>	<u>150</u>

WELL LOCATION:
 sec 27 T 1 N R 3 E
2 miles N.E. of Marshall
 (distance) (direction) (nearest town)

WELL PURPOSE drilling
 (home, irrigation, municipal, industrial)

CODED


- WELL COMPLETION DATA:
- (1) diameter (inches) 4"
 - (2) total depth (feet) 150 feet
 - (3) static water level (feet) 10 p below above top of ground.
 - (4) casing PVC 150 feet
 (material) (depth)
 if telescope see back.
 (size)
 - (5) screen 7 ft 143
 (length) (depth to top)
4" gravel
 (size) (material)
 - (6) pump 3/4 14
 (HP) (yield gpm)
 (type power)
 - (7) electric log Elect
 (yes or no)
 (organization running log)
 - (8) how well bottom plugged 4" cap

DRILLERS REMARKS:

MISSISSIPPI
 BOARD OF WATER COMMISSIONERS
 WATER CONTROL

If well telescopes please sketch and show depths.

GROUND LEVEL

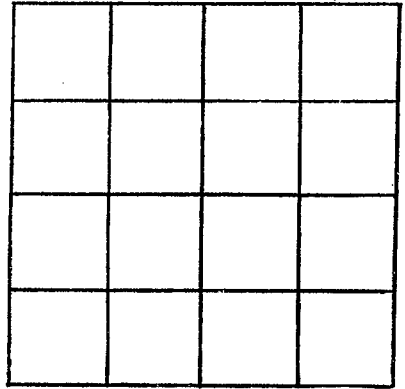

SECTION _____

Please indicate well location X.

ADDITIONAL INFORMATION

If more than one screen,
show locations of each on sketch.