

MARSHALL
B42
10-8-73

MISSISSIPPI
 BOARD OF WATER COMMISSIONERS
 416 North State Street
 Jackson, Mississippi 39201

CODED

WATER WELL DRILLERS LOG

Oct 8 19 73 R. L. Carpenter Marshall
 date well completed firm name county well located

LANDOWNER: John Pierce
Mt. Pleasant, Miss.
 (mailing address)


WELL LOCATION:
 sec. 13 T 1 N R 3 E
in Mt. Pleasant, Miss.
 (distance) miles (direction) (nearest town)

WELL PURPOSE: Home
 (home, irrigation, municipal, industrial)

- WELL COMPLETION DATA:
- (1) diameter (inches) 4 1/2"
 - (2) total depth (feet) 145
 - (3) static water level (feet) 93 below above top of ground.
 - (4) casing Plastic, 134 ft.
 (material) (depth)
 (size) If telescope see back.
 - (5) screen 6 ft, 134 ft
 (length) (depth to top)
Yes, Plastic & Steel
 (size) (material)
 - (6) pump 1/2 8
 (HP) (yield gpm)
9 hp.
 (type power)
 - (7) electric log No
 (yes or no)
 (organization running log)
 - (8) how well bottom plugged Plastic Casing

description of formations encountered	from	to
Surface	0	15
Med. Brown Sand	15	30
Med. White Sand	30	60
white clay	60	68
Fine White Sand	68	96
Coarse White Sand	96	140

CODED

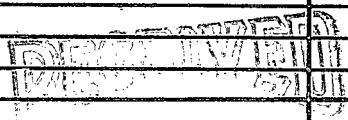


MAR 12 1974

DRILLERS REMARKS:

If well telescopes please sketch and show depths.

GROUND LEVEL

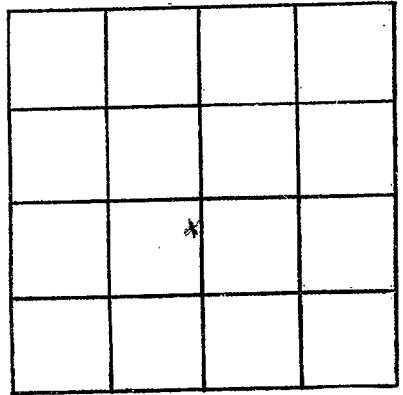

SECTION 33

Please indicate well location X.

ADDITIONAL INFORMATION

If more than one screen, show locations of each on sketch.