

MARSHALL

B45

4-20-74

MISSISSIPPI BOARD OF WATER COMMISSIONERS
416 North State Street
Jackson, Mississippi 39201

CODED

WATER WELL DRILLERS LOG

April 20 1974
date well completed

R. L. Carpenter
firm name

Marshall
county well located

LANDOWNER: Beauvelt Craft

Rossville town,

RFD

(mailing address)

WELL LOCATION:

sec. 28 T. 1 N. R. 3 E.
1 miles South of Millbrook
(distance) (direction) (nearest town)

WELL PURPOSE: Home
(home, irrigation, municipal, industrial)

WELL COMPLETION DATA:

- (1) diameter (inches) 4
- (2) total depth (feet) 140
- (3) static water level (feet) 75 below top of ground.
- (4) casing plastic, 134ft.
(material) (depth)

(size) if telescope see back.

- (5) screen 1ft., 134ft.
(length) (depth to top)
- 4in., plastic w/ sand
(size) (material)

- (6) pump 1/2, 8
(HP) (yield gpm)
- Elec.
(type power)

- (7) electric log No.
(yes or no)

(organization running log)

- (8) how well bottom plugged plastic cap


DRILLERS REMARKS:

description of formations encountered	from	to
<u>Surface Soil</u>	<u>0</u>	<u>18</u>
<u>med. Red sand</u>	<u>18</u>	<u>29</u>
<u>med. white clay</u>	<u>29</u>	<u>60</u>
<u>med. white sand</u>	<u>60</u>	<u>98</u>
<u>white coarse sand</u>	<u>98</u>	<u>140</u>

OCT - 4 1974
MISS. BD. OF WATER COMMISSIONERS

If well telescopes please sketch and show depths.

GROUND LEVEL

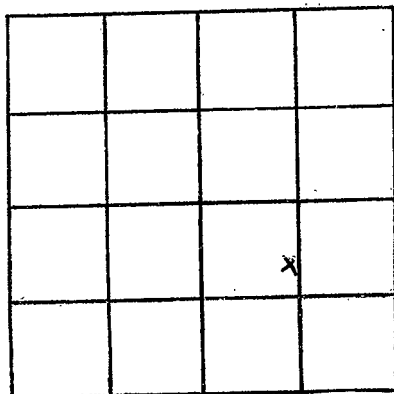

SECTION 28

Please indicate well location X.

ADDITIONAL INFORMATION

If more than one screen, show locations of each on sketch.