

MARSHALL  
B 47  
3-22-74

MISSISSIPPI  
BOARD OF WATER COMMISSIONERS  
416 North State Street JACKSON, MISSISSIPPI 39201  
CODED

WATER WELL DRILLERS LOG

Mar. 22 1974 R. L. Carpenter Marshall  
date well completed firm name county well located

LANDOWNER: C. W. Mc Cool  
Mt. Pleasant  
Miss.  
(mailing address)


description of formations encountered	from	to
Surface Soil	0	15
Med. Red Sand	15	43
Med. white sand	43	84
White Clay	84	161
White Coarse Sand	161	155

WELL LOCATION:  
sec. 35 T-1 N R-3 E  
2 miles East of Mt. Pleasant  
(distance) (direction) (nearest town)

WELL PURPOSE: Home  
(home, irrigation, municipal, industrial)

- WELL COMPLETION DATA:
- (1) diameter (inches) 4
  - (2) total depth (feet) 155
  - (3) static water level (feet) 139 below top of ground.
  - (4) casing Plastic, 151 ft. (material) (depth)  
(size) if telescope see back.
  - (5) screen 4 ft. 151 ft. (length) (depth to top)  
6 in. Plastic & Sand (size) (material)
  - (6) pump 1/2 8 (HP) (yield gpm)  
Elec. (type power)
  - (7) electric log no. (yes or no)
  - (8) how well bottom plugged Plastic Cap

DRILLERS REMARKS:

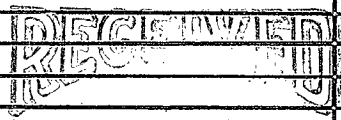

OCT 1 1974

