

MARSHALL
B 49

MISSISSIPPI DEPARTMENT OF NATURAL RESOURCES
Bureau of Land and Water Resources
Southport Mall
P.O. Box 10631
Jackson, Mississippi 39209
CODED WATER WELL DRILLERS LOG

7 - 17 1985 Larry Carpenter Wells Marshall
date well completed firm name county well located

LANDOWNER: Baptist Church
Mt. Pleasant, Ms.
(mailing address)

WELL LOCATION:
sec 30 T 1 N R 3 E
In Mt. Pleasant
(distance) miles (direction) of (nearest town)

WELL PURPOSE: Church
(home, irrigation, municipal, industrial)

- WELL COMPLETION DATA:
- (1) diameter (inches) 4
 - (2) total depth (feet) 160
 - (3) static water level (feet) 100 below above top of ground.
 - (4) casing PVC, 150' (material) (depth)
(size) if telescope see back.
 - (5) screen 10', 150' (length) (depth to top)
4 in., PVC (size) (material)
 - (6) pump 3/4 (HP) 12 (yield gpm)
2 hp (type power)
 - (7) electric log no. (yes or no)
(organization running log)
 - (8) how well bottom plugged PVC cap

description of formations encountered	from to	
<u>Surface Soil</u>	<u>0</u>	<u>14</u>
<u>Med. Brown Sand</u>	<u>14</u>	<u>30</u>
<u>White Clay</u>	<u>30</u>	<u>62</u>
<u>White Coarse Sand</u>	<u>62</u>	<u>89</u>
<u>White Clay</u>	<u>89</u>	<u>110</u>
<u>White Fine Sand</u>	<u>110</u>	<u>132</u>
<u>White coarse Sand</u>	<u>132</u>	<u>160</u>

CODED


RECEIVED
JUL 23 1986

Department of Natural Resources
Bureau of Land & Water Resources

DRILLERS REMARKS:

If well telescopes please sketch and show depths.

GROUND LEVEL

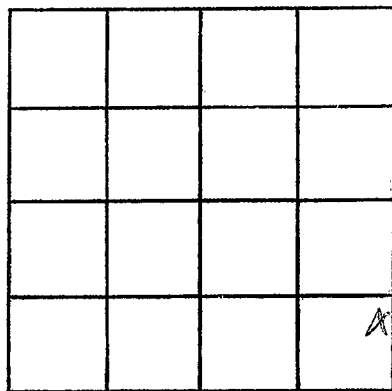

SECTION 33

Please indicate well location X.

ADDITIONAL INFORMATION

If more than one screen, show locations of each on sketch.