	State Well Report	For Office Use Only:
	Part 1 – Driller's Log	
County: Marshall	Mississippi Department of Environmental Quality	Aquifer:
Permit #:	Office of Land and Water Resources	Well #: <u>B-67</u>
Driller: Jones w. Mo	P.O. Box 10631	
		L. S. Elevation:
Date drilling completed: $11 - (8 - 0)$	5 (601)961-5210 (601)354-6938 (fax)	E-log #:

State Law requires that this report be prepared by the license holder responsible for the work and filed with the Department at the above address within 30 days of completion of drilling of the well or borehole.

Department at the above dataress within 50 days of comp	Well or Borehole Location
Information on Well Owner	
(Landowner if borehole is not for a water well)	Latitude: 34 . 57 . Hos, Longitude: 89 . 31 . 851"
Dwner Name_ Jerry Richards	Method of Lat/Long (circle one): Conventional Survey,
Mailing Address: 264 Tasko d.	USGS quad, Mand-held GPS, Survey-grade GPS
	NW SW 33 Negret Town
254 (0	DE 14 Sec 23 Inn
MT Pleasant MS 38649 City State Zip Code	Distance Direction Nearest Town Miles Sw of Mt Pleasant
Telephone No. (901) 828-0016	on East pide of Jasha Rd.
Well / Bor	rehole Data
Date drilling started: $(1 - 13 - 97)$ Date drilling completed: $11 - 13 - 13$	Hole depth: 140' Hole diameter: 8'
	2A
Location of the source of any surface water used for drilling: Method of dosing and volume of Chlorine used in drilling and dev	velopment:A
Method of dosing and volume of chreme and control of chreme and control of chreme and control of chreme and control of chreme and ch	
Purpose of borehole (check one): Water Well Geotechnical/Ge	cological Investigation Ground Source Heat Pump
Seismic SurveyOther (descri If drilling is not related to water_well construct	tion, skip the remainder of this block
If ariting is not related to water	
Purpose of Well (check one): Home Industrial Public Sup	ply Irrigation Fish Culture Outer
If a flowing well, method of flow regulation: ValveA	Other (describe)
Di Gatabava ar below trircle on	be) land surface Date measured: 11-10-05
tintered steel tane electric ta	ape air line other: <u>String</u>
Well grouted to a depth of 10 feet T	ype of grout (circle one): Neat Cement Bentonite Mix
Casing length: feet Casing diameter:	inches Type of casing:
Screen length: feet Screen diameter:4	inches Type of screen:
Screen length: <u>10</u> feet Screen diameter: <u></u>	m <u>100</u> feet to <u>100</u> rout
U directo all applicable): Gravel packed U	inderreamed Telescoped Open hole Natural Development
Other (describe):	14.
Top of lap pipe or reduction in casing:Afeet.	If telescoped or more than one screen, describe on next page
Tob or the bit.	Form: OLWR-SWR

DEC 0 5 2005 BY: OLWR

B-69


The sketch below only required for water wells

If well telescopes, show depths on sketch. Ground Level-

scription of Formations Encountered	From (depth)	To (depth)
Clay dirt.	Ground Level	3Ô
white soul	30	70
while clay	70	72
while soud	72	08
while clay	රිට	90
white souch	69	140
	1	
		_

Description of formations encountered must be provided for all

If more than one screen, show location of each on sketch

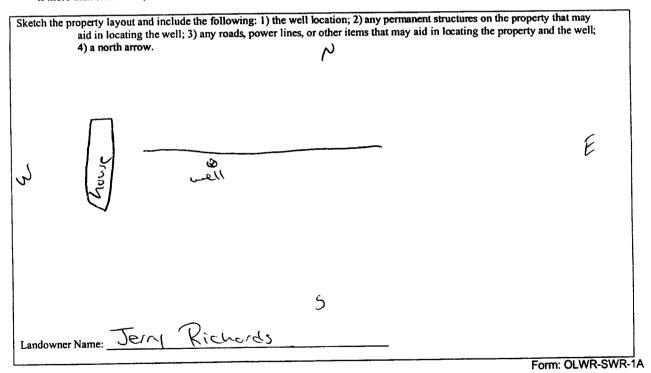

I certify that the well/borehole was drilled, constructed, and completed in accordance with all applicable requirements of the Mississippi Department of Environmental Quality and the Mississippi Department of Health regulations, if applicable, and state

laws.

Wasa 0630 cne

(1 - 30 - 05)

fano us Maran

Print Name of Responsible Licensee and License No.

Date

Signature of Licensee

RECEIVED DEC 0 5 2005 BY: OLWR

STATE WELL REPORT						
County: Marshall Permit #: Driller: Jones w. Masan Date completed: <u>11-18-05</u> <u>Copy information from block on Part 1</u> This part of the report must be completed by report must be attached and both parts filed Well Owner Information Owner Name: Jerry Richer	Pump Installer's Mississippi Departmen Office of Land a P.O. E Jackson, M (601) (601)35- y a licensed water well of with the Department a	t the above address within 30 de Wel	ays of well completion. I Location			
Mailing Address: <u>264 Taska ral</u> <u>Mailing Address:</u> <u>264 Taska ral</u> <u>Mr Pleasant MS 38649</u> <u>City State Zip Code</u> Telephone No. (<u>901) 828-0016</u>		Latitude: $34.57.165$ Longitude: $87.31.851$ Method of Lat/Long (check one): Conventional Survey_, USGS quad, Hand-held GPS_, Survey-grade GPS, NE $45E$ 4 Sec 32 T 15 R $3W$ Distance Direction Nearest Town <u>I</u> Miles $5W$ of MT $Plecsent$				
		Diesel Engine Gasoli Electric Motor Hand Windmill Other				
Pump Test Data Date Well Tested: $11 - 18 - 05$ Static Water Level (A): 20 Feet I Pumping Water Level (A): 20 Feet I Pumping Water Level (B): 20 Feet I Drawdown [(B) - (A)]: 20 Feet I Test Pumping Rate: 12 Duration of Pump Test (minimum 4 hours):	Below Land Surface Below Land Surface Gallons Per Minute	Air Line Electric Me Other (specify):	easuring Water Level Circle one asuring Linc Steel Tape $s_{3} = 1$ $wei_{3} \land h$ shut in head: NA feet GPM with a drawdown of $\exists 4$ hours of pumping			
I HEREBY CERTIFY that the above statem <u>Jones</u> <u>W. Mascu</u> Print Name of Pump Installer and License N	_	of my knowledge. for Markow Signature of Pump	3			

.

۲.

1

DEC 0 5 2005 BY: OLWR