

MARSHALL
 B 2000
 3-18-76

MISSISSIPPI
 BOARD OF WATER COMMISSIONERS
 416 North State Street
 Jackson, Mississippi 39201

WATER WELL DRILLERS LOG


3-18 date well completed
 1976 Dean Kent Burpach firm name
 Marshall county well located

LANDOWNER: James Moore
 800 Rt. B. x117
 Mt. Pleasant (mailing address) Miss.
 WELL LOCATION:
 sec. 27 T. 1 N. R. 3 E.
 1 miles North of Mt. Pleasant
 (distance) (direction) (nearest town)

description of formations encountered	from	to
clay	0	30
sand	30	80
clay	80	90
sand	90	155

WELL PURPOSE: drinking
 (home, irrigation, municipal, industrial)


WELL COMPLETION DATA:
 (1) diameter (inches) 4"
 (2) total depth (feet) 155 feet
 (3) static water level (feet) 90 below above top of ground.
 (4) casing PVC 155 feet (material) (depth)
 (size) if telescope see back.
 (5) screen 7 ft 178 feet (length) (depth to top)
 4" gravel wall (size) (material)
 (6) pump 1/2 10 (HP) (yield gpm)
 (type power)
 (7) electric log elect. (yes or no)
 (organization running log)
 (8) how well bottom plugged 4" cap.

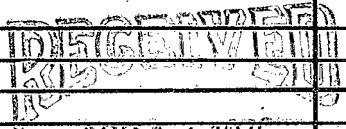

DRILLERS REMARKS:

If well telescopes please sketch and show depths.

GROUND LEVEL

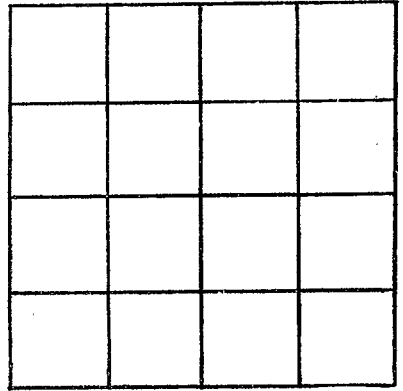

SECTION _____

Please indicate well location X.

ADDITIONAL INFORMATION

If more than one screen, show locations of each on sketch.