

MARSHALL
B 2001
7-22-76

MISSISSIPPI
 BOARD OF WATER COMMISSIONERS
 416 North State Street
 Jackson, Mississippi 39201

WATER WELL DRILLERS LOG

7-22-1976 *Dean Kent Bumpstead* firm name *Marshall* county well located

LANDOWNER:
Junior Oster
mt. pleasant, miss.
 (mailing address)

description of formations encountered	from	to
<i>clay</i>	<i>0</i>	<i>20</i>
<i>sand</i>	<i>20</i>	<i>160</i>

WELL LOCATION:
 sec. *33* T *1* N R *3* E
1/2 miles *west* of *mt. pleasant*
 (distance) (direction) (nearest town)

WELL PURPOSE: *Drainage*
 (home, irrigation, municipal, industrial)

- WELL COMPLETION DATA:
- (1) diameter (inches) *4"*
 - (2) total depth (feet) *160 feet*
 - (3) static water level (feet) *110* below above top of ground.
 - (4) casing *pvc* *160 feet*
 (material) (depth)
 (size) If telescope see back.
 - (5) screen *7 ft.* *153 feet*
 (length) (depth to top)
4" *gravel wall*
 (size) (material)
 - (6) pump *3/4* *14*
 (HP) (yield gpm)
 (type power)
 - (7) electric log *Elect.*
 (yes or no)
 (organization running log)
 - (8) how well bottom plugged *4" w/*


DRILLERS REMARKS:

RECEIVED
 AUG 12 1976

MISS. BD. OF WATER COMMISSIONERS

If well, telescopes please
sketch and show depths.

GROUND LEVEL

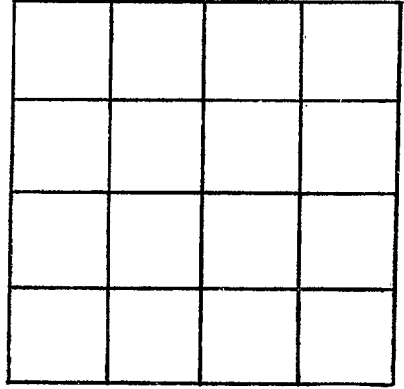

SECTION _____

Please indicate well location X.

ADDITIONAL INFORMATION

If more than one screen,
show locations of each on sketch.