

MARSHALL

B 2003

9-1-78

MISSISSIPPI BOARD OF WATER COMMISSIONERS
416 North State Street
Jackson, Mississippi 39201

WATER WELL DRILLERS LOG

9-1 1978 Rembert Burdette Marshall
date well completed firm name county well located

LANDOWNER:

Walker Howell
Mt. Pleasant, Miss.
(mailing address)

description of formations encountered:

from to

clay 0 20
sand 20 60

WELL LOCATION:

sec. 35 T 1 N R. 3 E
2 miles East of Mt. Pleasant
(distance) (direction) (nearest town)

clay 60 65
sand 65 170

WELL PURPOSE: Drilling
(home, irrigation, municipal, industrial)

WELL COMPLETION DATA:

- (1) diameter (inches) 4"
- (2) total depth (feet) 170 feet
- (3) static water level (feet) 80 below above top of ground.
- (4) casing PVC, 170 feet
(material) (depth)
(size) if telescope see back.
- (5) screen 24", 163 feet
(length) (depth to top)
4", Gravel
(size) (material)
- (6) pump 3/4, 14
(HP) (yield gpm)
(type power)
- (7) electric log steel
(yes or no)
(organization running log)
- (8) how well bottom plugged 4" cpi

RECORDED
INDEXED


OCT 13 1978

DRILLERS REMARKS:

MISS. BD. OF WATER COMM

If well telescopes please sketch and show depths.

GROUND LEVEL

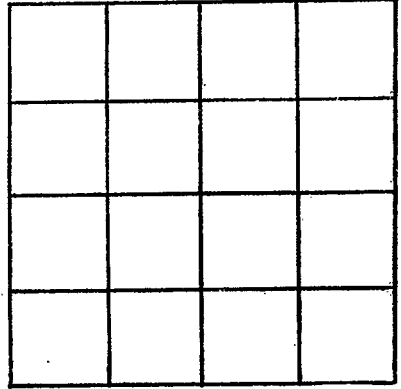

SECTION _____

Please indicate well location X.

ADDITIONAL INFORMATION

If more than one screen, show locations of each on sketch.