

MARSHALL
B
9-19-78
2004
9-19

**MISSISSIPPI
BOARD OF WATER COMMISSIONERS**
416 North State Street
Jackson, Mississippi 39201

WATER WELL DRILLERS LOG

date well completed 9-19-78 firm name B. Deant Kent Co. Inc. county well located Marshall


LANDOWNER:	description of formations encountered	from	to
<u>Elsie Smith</u> <u>Mt. Pleasant, Miss.</u> (mailing address)			
WELL LOCATION: sec. <u>33</u> T <u>1</u> N. R. <u>3</u> E <u>1</u> miles <u>West</u> of <u>Mt. Pleasant</u> (distance) (direction) (nearest town)	<u>Sand</u>	<u>20</u>	<u>70</u>
WELL PURPOSE: <u>Domestic</u> (home, irrigation, municipal, industrial)	<u>Clay</u>	<u>70</u>	<u>80</u>
WELL COMPLETION DATA:	<u>Sand</u>	<u>80</u>	<u>150</u>
(1) diameter (inches) <u>4"</u>			
(2) total depth (feet) <u>150 feet</u>			
(3) static water level (feet) <u>100</u> below top of ground.			
(4) casing <u>pvc</u> <u>150 feet</u> (material) (depth)			
(size) If telescope see back.			
(5) screen <u>7ft.</u> <u>143 feet</u> (length) (depth to top)			
<u>4"</u> <u>Sand waf.</u> (size) (material)			
(6) pump <u>3/4</u> <u>14</u> (HP) (yield gpm)			
(type power)			
(7) electric log <u>Elect.</u> (yes or no)			
(organization running log)			
(8) how well bottom plugged <u>4" Cof.</u>			
DRILLERS REMARKS:			

OCT 13 1978

MISS. BD. OF WATER COMM

If well telescopes please sketch and show depths.

GROUND LEVEL

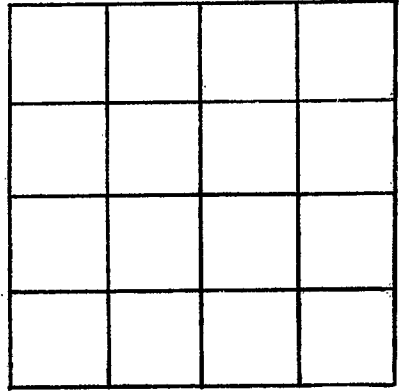

SECTION _____

Please indicate well location X.

ADDITIONAL INFORMATION

If more than one screen, show locations of each on sketch.