

MARSHALL
B.
12-05-77
2007

**MISSISSIPPI
BOARD OF WATER COMMISSIONERS**
416 North State Street
Jackson, Mississippi 39201

WATER WELL DRILLERS LOG

Dec. 5 1977 R. L. Lopez Marshall
date well completed firm name county well located

LANDOWNER: <u>Troy Willard</u>		description of formations encountered	from	to
<u>Mt. Pleasant, Miss.</u>				
(mailing address)		<u>Surface Soil</u>	<u>0</u>	<u>14</u>
WELL LOCATION:		<u>Red Red Sand</u>	<u>14</u>	<u>35</u>
sec. <u>33</u> -T- <u>1</u> -N	R- <u>3</u> -E	<u>White Clay L</u>	<u>35</u>	<u>90</u>
<u>S</u>	<u>W</u>	<u>White Fine Sand</u>		
<u>1/2</u> miles <u>west</u> of <u>Mt. Pleasant</u>	(distance) (direction) (nearest town)	<u>Red White Sand</u>	<u>90</u>	<u>110</u>
WELL PURPOSE: <u>Home</u>		<u>White coarse sand</u>	<u>110</u>	<u>145</u>
(home, irrigation, municipal, industrial)				
WELL COMPLETION DATA:				
(1) diameter (inches)	<u>4</u>			
(2) total depth (feet)	<u>145</u>			
(3) static water level (feet)	<u>167</u>			
	below above			
	top of ground.			
(4) casing <u>Plastic</u>	<u>135'</u>			
(material)	(depth)			
	(size) If telescope see back.			
(5) screen <u>10'</u>	<u>135'</u>			
(length)	(depth to top)			
<u>4"</u>	<u>Plastic</u>			
(size)	(material)			
(6) pump <u>3/4</u>	<u>10</u>			
(HP)	(yield gpm)			
<u>Fluo.</u>				
(type power)				
(7) electric log <u>No.</u>				
	(yes or no)			
	(organization running log)			
(8) how well bottom plugged <u>Plu Cap</u>				

DRILLERS REMARKS:


Miss. Board of Water Comm.

MAR 12 1979

RECEIVED

If well telescopes please sketch and show depths.

GROUND LEVEL

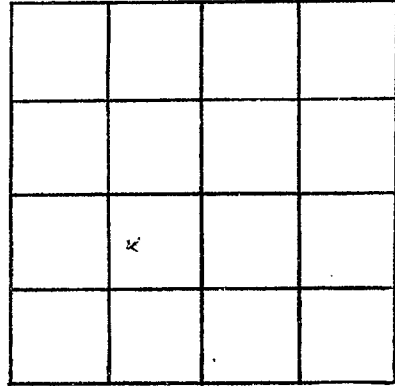

SECTION 33

Please indicate well location X.

ADDITIONAL INFORMATION

If more than one screen,
show locations of each on sketch.