

MARSHALL
B 2010

MISSISSIPPI
BOARD OF WATER COMMISSIONERS
416 North State Street
Jackson, Mississippi 39201

WATER WELL DRILLERS LOG

12/5/78
Dec. 5

1978 R. L. Carpenter

Marshall

date well completed

firm name

county well located

LANDOWNER: James Williams Jr.
Russville, Tenn
RFD
(mailing address)

description of formations encountered

from

to

Surface Soil	0	18
Coarse white sand	18	50
white clay	50	74
white fine sand	74	96
white coarse sand	96	128

WELL LOCATION:

sec. 34 T 1 N R 3 E
S W
1 miles N.E. of Int. Phoscat
(distance) (direction) (nearest town)

WELL PURPOSE: None
(home, irrigation, municipal, industrial)

WELL COMPLETION DATA:

- (1) diameter (inches) 4
- (2) total depth (feet) 128
- (3) static water level (feet) 90 below above top of ground.
- (4) casing Plaster 118'
(material) (depth)
(size) if telescope see back.
- (5) screen 16" 118'
(length) (depth to top)
4" Plaster
(size) (material)
- (6) pump 3/4 12
(HP) (yield gpm)
Elec.
(type power)
- (7) electric log no
(yes or no)

(organization running log)

(8) how well bottom plugged puccop

DRILLERS REMARKS:


DEPT. OF NATURAL RESOURCES
BUREAU OF LAND & WATER RESOURCES

MAY 28 1981

RECEIVED

If well telescopes please sketch and show depths.

GROUND LEVEL

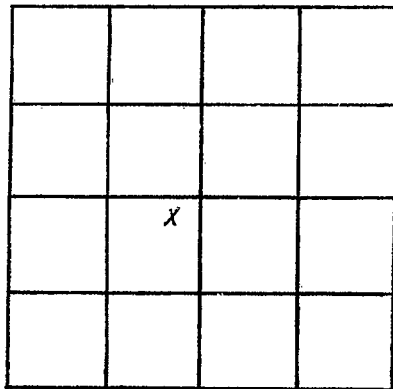

SECTION 34

Please indicate well location X.

ADDITIONAL INFORMATION

If more than one screen, show locations of each on sketch.