

MARSHALL
28 2012
6/15/79
June 15

MISSISSIPPI
 BOARD OF WATER COMMISSIONERS
 416 North State Street
 Jackson, Mississippi 39201

WATER WELL DRILLERS LOG

date well completed 1979 firm name R. L. Carpenter county well located Marshall

LANDOWNER: D. S. Henswicker
Pt. Pleasant man
Gen. Del.
 (mailing address)

description of formations encountered	from	to
<u>Surface Soil</u>	<u>0</u>	<u>12</u>
<u>Med. Red Sand</u>	<u>12</u>	<u>32</u>
<u>White Fine Sand</u>	<u>32</u>	<u>64</u>
<u>White Clay</u>	<u>64</u>	<u>90</u>
<u>Med. White Sand</u>	<u>90</u>	<u>98</u>
<u>White Coarse Sand</u>	<u>98</u>	<u>120</u>

WELL LOCATION:
 sec. 33 T 1 N R 3 E
1/4 miles West of Pt. Pleasant
 (distance) (direction) (nearest town)

WELL PURPOSE: Home
 (home, irrigation, municipal, industrial)

- WELL COMPLETION DATA:
- (1) diameter (inches) 4
 - (2) total depth (feet) 120
 - (3) static water level (feet) 10' below top of ground.
 - (4) casing Plastic, 118'
 (material) (depth)
 (size) if telescope see back.
 - (5) screen 18', 110'
 (length) (depth to top)
4", Plastic
 (size) (material)
 - (6) pump 1/2, 9
 (HP) (yield gpm)
Eber
 (type power)
 - (7) electric log No.
 (yes or no)
 (organization running log)
 - (8) how well bottom plugged PVC cap

DRILLERS REMARKS:


DEPT. OF NATURAL RESOURCES
 BUREAU OF LAND & WATER RESOURCES

MAY 18 1991

RECEIVED

If well telescopes please sketch and show depths.

GROUND LEVEL

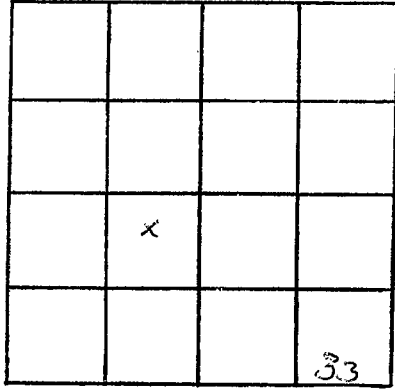

SECTION 33

Please indicate well location X.

ADDITIONAL INFORMATION

Lined area for additional information.

If more than one screen, show locations of each on sketch.