

MARSHALL
B 2014
9/15/79

MISSISSIPPI
BOARD OF WATER COMMISSIONERS
416 North State Street
Jackson, Mississippi 39201

WATER WELL DRILLERS LOG

Sept. 15 1979 R. L. Carpenter Marshall
date well completed firm name county well located

LANDOWNER: Richard DeBryant's
Rossville, Tenn.
RFD
(mailing address)

description of formations encountered	from	to
surface soil -	0	12
med Red soil	12	34
white med soil	34	60
+ white clay	60	72
white fine sand	72	84
white clay	84	100
white coarse sand	100	125

WELL LOCATION:
sec. 27 T-1 N R-3 E
S W
1 miles N.W. of Mt. Pleasant
(distance) (direction) (nearest town)

WELL PURPOSE: None
(home, irrigation, municipal, industrial)

WELL COMPLETION DATA:
(1) diameter (inches) 4
(2) total depth (feet) 125
(3) static water level (feet) 55 below above top of ground.
(4) casing PVC 115'
(material) (depth)
(size) if telescope see back.
(5) screen 16' 115'
(length) (depth to top)
4" PVC
(size) (material)
(6) pump 3/4 12
(HP) (yield gpm)
Elec.
(type power)
(7) electric log No.
(yes or no)
(organization running log)
(8) how well bottom plugged PVC caps

DRILLERS REMARKS:


DEPT. OF NATURAL RESOURCES
BUREAU OF LAND & WATER RESOURCES

MAY 18 1981

RECEIVED

If well telescopes please sketch and show depths.

GROUND LEVEL

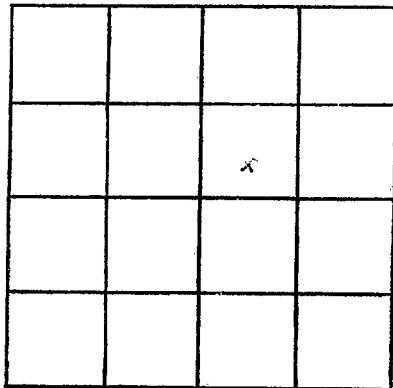

SECTION 27

Please indicate well location X.

ADDITIONAL INFORMATION

If more than one screen,
show locations of each on sketch.