

Marshall
B 2015
10/10/79

**MISSISSIPPI
BOARD OF WATER COMMISSIONERS
416 North State Street
Jackson, Mississippi 39201**

WATER WELL DRILLERS LOG

Not 10 19 29 R. L. Carpenter Marshall
date well completed firm name county well located

LANDOWNER: Frank Bonnell
Mt. Pleasant, Miss.
(mailing address)

WELL LOCATION:
sec. 35 T. 1 N. R. 3 E.
S. W.
2 miles East of Mt. Pleasant
(distance) (direction) (nearest town)

WELL PURPOSE: Home
(home, irrigation, municipal, industrial)

WELL COMPLETION DATA:

(1) diameter (inches) 4

(2) total depth (feet) 140

(3) static water level (feet) 90 below
top of ground.

(4) casing Plastic, 130
(material) (depth)
(size) if telescope see back.

(5) screen 10', 130'
(length) (depth to top)
4", Plastic
(size) (material)

(6) pump 1/2 9
(HP) (yield gpm)
Electric
(type power)

(7) electric log no
(yes or no)

(organization running log)

(8) how well bottom plugged P.W.C.

description of formations encountered	from	to
<u>Surface Soil</u>	<u>0</u>	<u>10</u>
<u>Med. S. S.</u>	<u>10</u>	<u>35</u>
<u>Med. White Sand</u>	<u>35</u>	<u>70</u>
<u>White fine sand</u>	<u>70</u>	<u>120</u>
<u>White Coarse sand</u>	<u>120</u>	<u>140</u>

DEPT. OF NATURAL RESOURCES
BUREAU OF LAND & WATER RESOURCES


MAY 18 1981

RECEIVED

DRILLERS REMARKS:

If well telescopes please sketch and show depths.

GROUND LEVEL

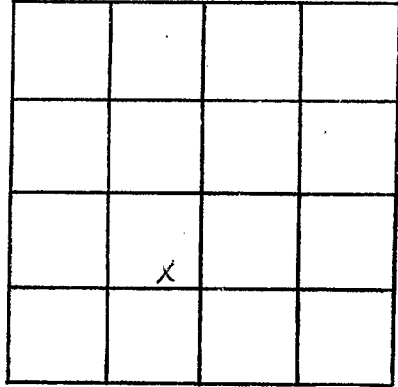

SECTION 35

Please indicate well location X.

ADDITIONAL INFORMATION

If more than one screen,
show locations of each on sketch.