

MARSHALL  
B 2018  
4/14/80  
4-14

MISSISSIPPI  
BOARD OF WATER COMMISSIONERS  
416 North State Street  
Jackson, Mississippi 39201

WATER WELL DRILLERS LOG

date well completed 1980 firm name R. L. Carpenter county well located Marshall

LANDOWNER: Miller Kieth  
Mt. Pleasant  
Miss. Gen. Del.  
(mailing address)

WELL LOCATION:  
sec 34 T 1 N R 3 E  
S W  
1/4 miles East of Mt. Pleasant  
(distance) (direction) (nearest town)

WELL PURPOSE: Home  
(home, irrigation, municipal, industrial)

WELL COMPLETION DATA:  
(1) diameter (inches) 4  
(2) total depth (feet) 145  
(3) static water level (feet) 101 below top of ground.  
(4) casing PVC 135'  
(material) (depth)  
(size) if telescope see back.  
(5) screen 10' 135'  
(length) (depth to top)  
4" PVC  
(size) (material)  
(6) pump 1/2 10  
(HP) (yield gpm)  
Elex  
(type power)  
(7) electric log no  
(yes or no)  
(organization running log)  
(8) how well bottom plugged PVC Cap


| description of formations encountered | from | to  |
|---------------------------------------|------|-----|
| Supine Soil                           | 0    | 16  |
| red & Fine Red Sand                   | 16   | 40  |
| White red. Sand                       | 40   | 75  |
| White clay                            | 75   | 96  |
| red & Fine White Sand                 | 96   | 115 |
| White coarse Sand                     | 115  | 145 |

DRILLERS REMARKS:

DEPT. OF NATURAL RESOURCES  
BUREAU OF LAND & WATER RESOURCES  
MAY 18 1981  
RECEIVED

If well telescopes please sketch and show depths.

GROUND LEVEL

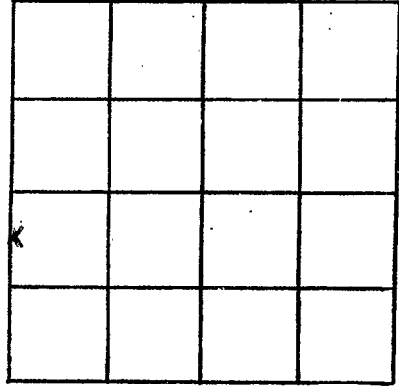

SECTION 34

Please indicate well location X.

ADDITIONAL INFORMATION

Lined area for additional information.

If more than one screen, show locations of each on sketch.