

Marshall  
B 2020  
5/14/80

MISSISSIPPI  
 BOARD OF WATER COMMISSIONERS  
 416 North State Street  
 Jackson, Mississippi 39201

WATER WELL DRILLERS LOG

date well completed May 14 1980 firm name R. D. Cowrite county well located Marshall

LANDOWNER: Floyd Fitzpatrick  
Rossville, Tenn.  
R. F. D.  
 (mailing address)

description of formations encountered	from	to
<u>Surface Soil</u>	<u>0</u>	<u>15</u>
<u>Coarse White Sand</u>	<u>15</u>	<u>54</u>
<u>White Clay &amp; Fine Sand</u>	<u>54</u>	<u>78</u>
<u>White med Sand</u>	<u>78</u>	<u>78</u>
<u>White Clay</u>	<u>90</u>	<u>105</u>
<u>White Coarse Sand</u>	<u>105</u>	<u>130</u>

WELL LOCATION:  
 sec. 34 T. 1 N. R. 3 E.  
1 1/2 miles East of Madison  
 (distance) (direction) (nearest town)

WELL PURPOSE: Home  
 (home, irrigation, municipal, industrial)

- WELL COMPLETION DATA:
- diameter (inches) 4
  - total depth (feet) 130
  - static water level (feet) 95 below top of ground.
  - casing PVC, 120'  
 (material) (depth)  
 (size) if telescope see back.
  - screen 18', 120'  
 (length) (depth to top)  
 (size) (material)
  - pump 1/2, 10  
 (HP) (yield gpm)  
Electric  
 (type power)
  - electric log No  
 (yes or no)  
 (organization running log)
  - how well bottom plugged PVC Cap


DRILLERS REMARKS:

DEPT. OF NATURAL RESOURCES  
 BUREAU OF LAND & WATER RESOURCES

MAY 18 1980  
 RECEIVED

If well telescopes please sketch and show depths.

GROUND LEVEL

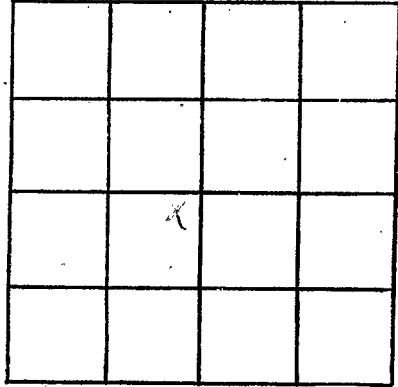

SECTION 388

Please indicate well location X.

ADDITIONAL INFORMATION

Lined area for additional information.

If more than one screen, show locations of each on sketch.