

Marshall
 B 2023
 7/20/80

MISSISSIPPI
 BOARD OF WATER COMMISSIONERS
 416 North State Street
 Jackson, Mississippi 39201

WATER WELL DRILLERS LOG

July 9th 1980 R.L. Carpenter Marshall
 date well completed firm name county well located

LANDOWNER: Mrs F Bailey
 Mt. Pleasant, Miss.
 (mailing address)

WELL LOCATION:
 sec. 33 T. 1 N R. 3 E
 In Mt. Pleasant S W
 (distance) (direction) (nearest town)

WELL PURPOSE: Home
 (home, irrigation, municipal, industrial)

- WELL COMPLETION DATA:
- (1) diameter (inches) 4
 - (2) total depth (feet) 133
 - (3) static water level (feet) 95 below above top of ground.
 - (4) casing Plastic, 123 (material) (depth)
 (size) if telescope see back.
 - (5) screen 10' 123 (length) (depth to top)
 4" Plastic (size) (material)
 - (6) pump 1/2 10 (HP) (yield gpm)
 5 hp (type power)
 - (7) electric log no (yes or no)
 (organization running log)
 - (8) how well bottom plugged PVC caps


description of formations encountered	from	to
Surface Soil	0	10
Coarse Brown Sand	10	28
Clay	28	35
Med. Whit. Sand	35	70
White Clay	70	86
White Fine Sand	86	100
White Coarse Sand	100	133

DRILLERS REMARKS:

DEPT. OF NATURAL RESOURCES
 BUREAU OF LAND & WATER RESOURCES
 MAY 16 1981
 RECEIVED

If well telescopes please sketch and show depths.

GROUND LEVEL

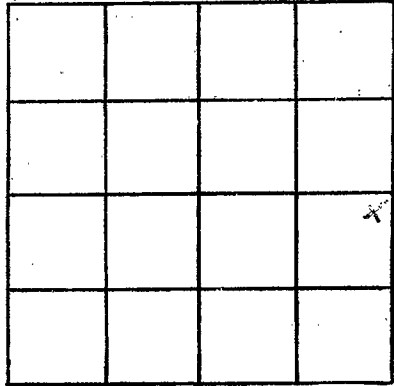

SECTION 33

Please indicate well location X.

ADDITIONAL INFORMATION

If more than one screen,
show locations of each on sketch.