

MARSHALL
 B 2005
 3-24-80

MISSISSIPPI
 BOARD OF WATER COMMISSIONERS
 416 North State Street
 Jackson, Mississippi 39201

WATER WELL DRILLERS LOG

3-24 1980 Pleasant Springs well Marshall
 date well completed firm name county well located

LANDOWNER:
 Don Warner
 Mt Pleasant, Miss.
 (mailing address)

description of formations encountered	from	to
clay	0	20
sand	20	160

WELL LOCATION:
 sec 33 T 1 N R 3 E
 4 miles west of Mt Pleasant
 (distance) (direction) (nearest town)

WELL PURPOSE: Drinking
 (home, irrigation, municipal, industrial)

- WELL COMPLETION DATA:
- (1) diameter (inches) 4"
 - (2) total depth (feet) 160 feet
 - (3) static water level (feet) 30 above top of ground
 - (4) casing PVC, 160 feet
 (material) (depth)
 (size) if telescope see back.
 - (5) screen 7 ft, 153 feet
 (length) (depth to top)
4", gravel wall
 (size) (material)
 - (6) pump 3/4 14
 (HR) (yield gpm)
 (type power)
 - (7) electric log flat
 (yes or no)
 (organization running log)
 - (8) how well bottom plugged 4" cof

DRILLERS REMARKS:


DEPT. OF NATURAL RESOURCES
 BUREAU OF LAND & WATER RESOURCES

APR 22 1980

RECEIVED

If well telescopes please sketch and show depths.

GROUND LEVEL

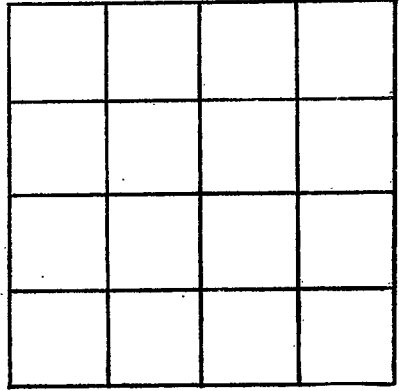

SECTION _____

Please indicate well location X.

ADDITIONAL INFORMATION

If more than one screen, show locations of each on sketch.