

MISSISSIPPI DEPARTMENT OF NATURAL RESOURCES

Bureau of Land and Water Resources

Southport Mall

P.O. Box 10631

Jackson, Mississippi 39209

WATER WELL DRILLERS LOG

<u>Marshall</u>
<u>B 2027</u>
<u>5-25-81</u>

date well completed

19 81 R. D. Carpenter

firm name

Marshall
county well located

LANDOWNER:

David Hall

description of formations encountered

from

to

Mt. Pleasant,

Surface Soil

0

18

Miss.

(mailing address)

Med. Red Sand

18

40

WELL LOCATION:

sec. 34 T. 1 N. R. 3 E.

(S)

(W)

Med White Sand

40

65

1/2 miles (distance)

East (direction)

of Mt. Pleasant (nearest town)

White Clay

65

90

WELL PURPOSE:

Home

(home, irrigation, municipal, industrial)

White Coarse Sand

90

123

WELL COMPLETION DATA:

(1) diameter (inches)

4

(2) total depth (feet)

123

(3) static water level (feet) 85 below top of ground.

(4) casing

PVC (material)

113 (depth)

(size) if telescope see back.

(5) screen

10' (length)

113' (depth to top)

4" (size)

PVC (material)

(6) pump

1/2 (HP)

10 (yield gpm)

Elec. (type power)

(7) electric log

No. (yes or no)

DEPT. OF NATURAL RESOURCES
BUREAU OF LAND & WATER RESOURCES

(organization running log)

(8) how well bottom plugged

PVC cap


DRILLERS REMARKS:

SEP - 7 1982

RECEIVED

If well telescopes please sketch and show depths.

GROUND LEVEL

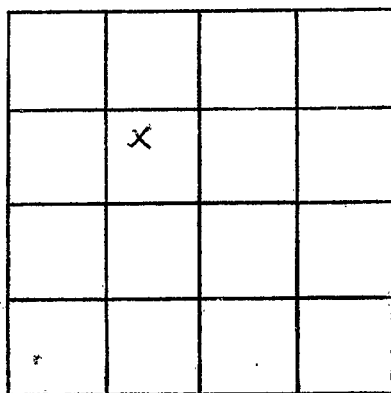

SECTION 34

Please indicate well location X.

ADDITIONAL INFORMATION

If more than one screen,
show locations of each on sketch.